
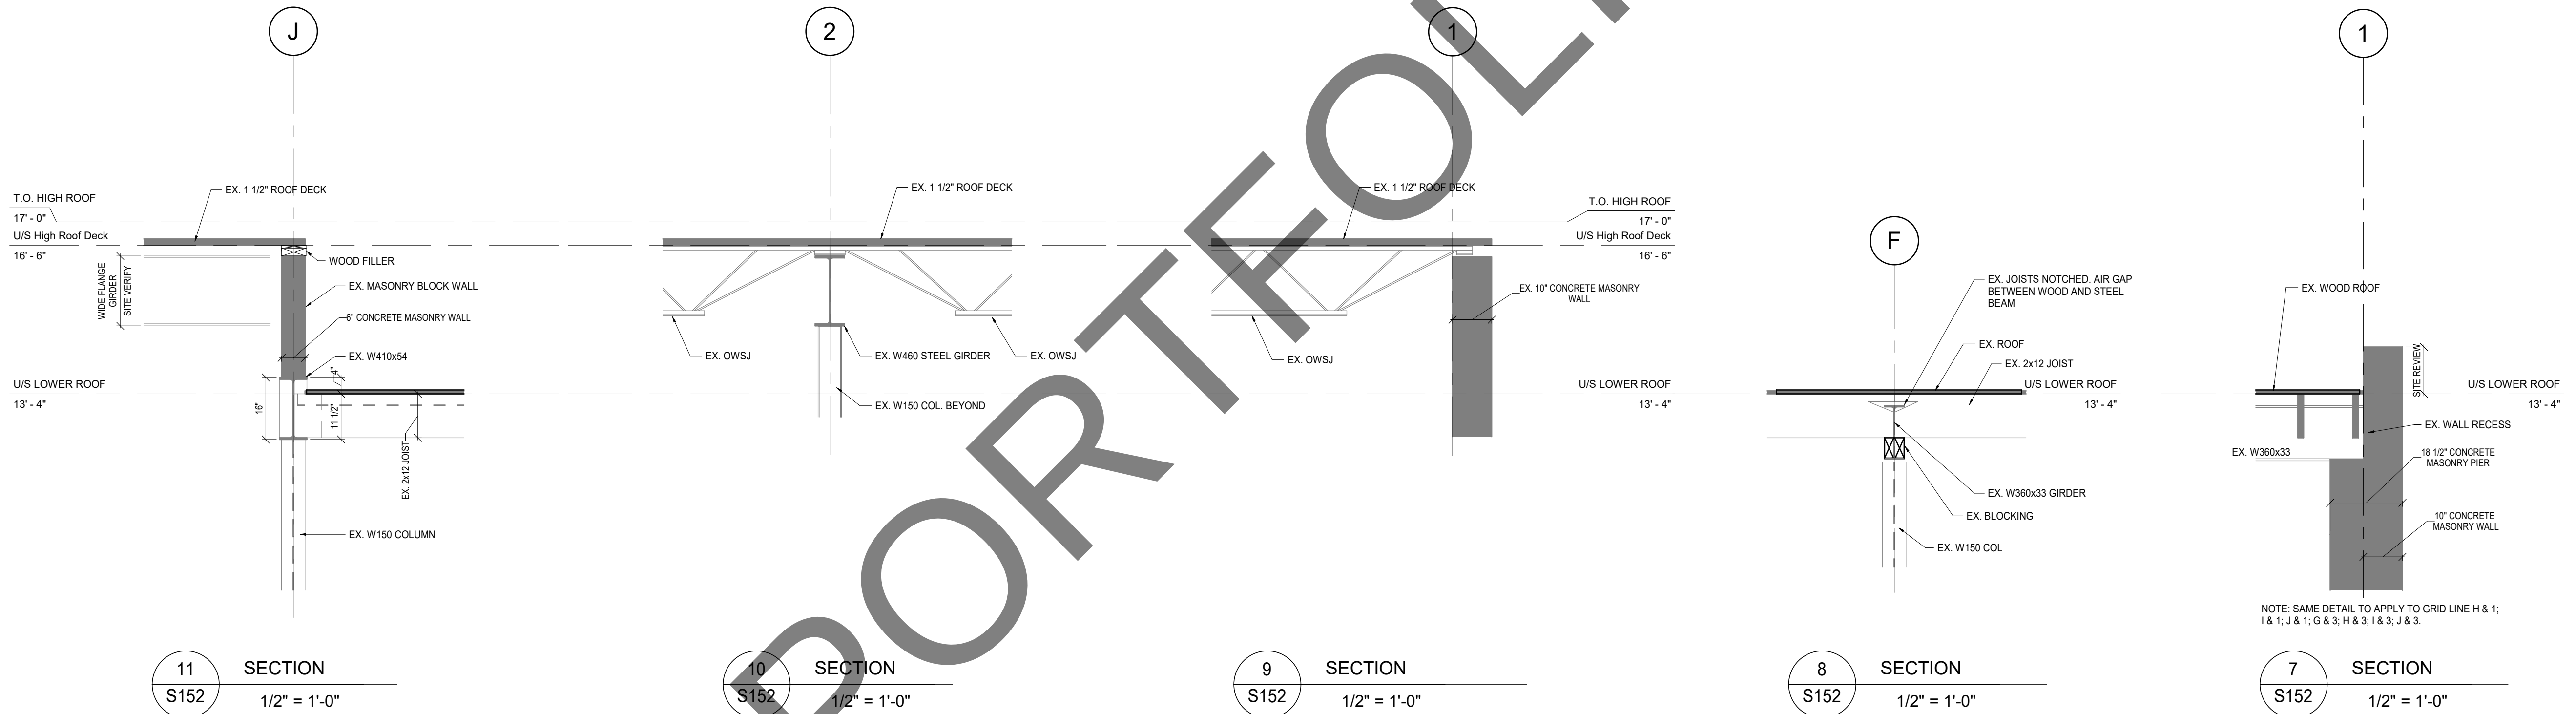


REVISIONS / ISSUE		
NO.	DATE	
1	2025-05-21	ISSUED FOR PERMIT
2	2025-07-16	ISSUED FOR UPDATES
DISCLAIMER CONTRACTOR IS RESPONSIBLE FOR FIELD VERIFYING ALL DIMENSIONS. ANY DISCREPANCIES SHALL BE REPORTED TO THE ARCHITECT PRIOR TO PROCEEDING WITH THE WORK. DRAWINGS ARE NOT TO BE SCALED. "ALL DRAWINGS, SPECIFICATIONS AND RELATED DOCUMENTS ARE THE COPYRIGHTED PROPERTY OF THE ARCHITECT AND MUST BE RETURNED UPON REQUEST. REPRODUCTION OF DRAWINGS, SPECIFICATIONS AND RELATED DOCUMENTS IN PART OR WHOLE IS FORBIDDEN WITHOUT THE ARCHITECT'S WRITTEN PERMISSION." NOTIFY ARCHITECT OF ANY DISCREPANCIES AND WAIT FOR INSTRUCTION PRIOR TO PROCEEDING WITH WORK.		
		
 Quinn Dressel ASSOCIATES CONSULTING STRUCTURAL ENGINEERS		
 FLAT IRON BUILDING GROUP		
 paradigm architecture + design [1] 416.686.3624 www.paradigm-ad.com		
STAMP:		
PROJECT NAME / LOCATION:		
100071257 ONTARIO LTD. BUILDING RENOVATION		
78 ADVANCE RD, ETOBICOKE, ON, M8Z 2T7		
DRAWING TITLE:		
EXISTING BUILDING SECTIONS		
DRAWN BY:	PROJECT NO.:	
MH	24-327	
CHECKED BY:	SCALE:	
RY	As indicated	
	DATE:	
	2025-07-16	
	DRAWING NO.:	
		S152

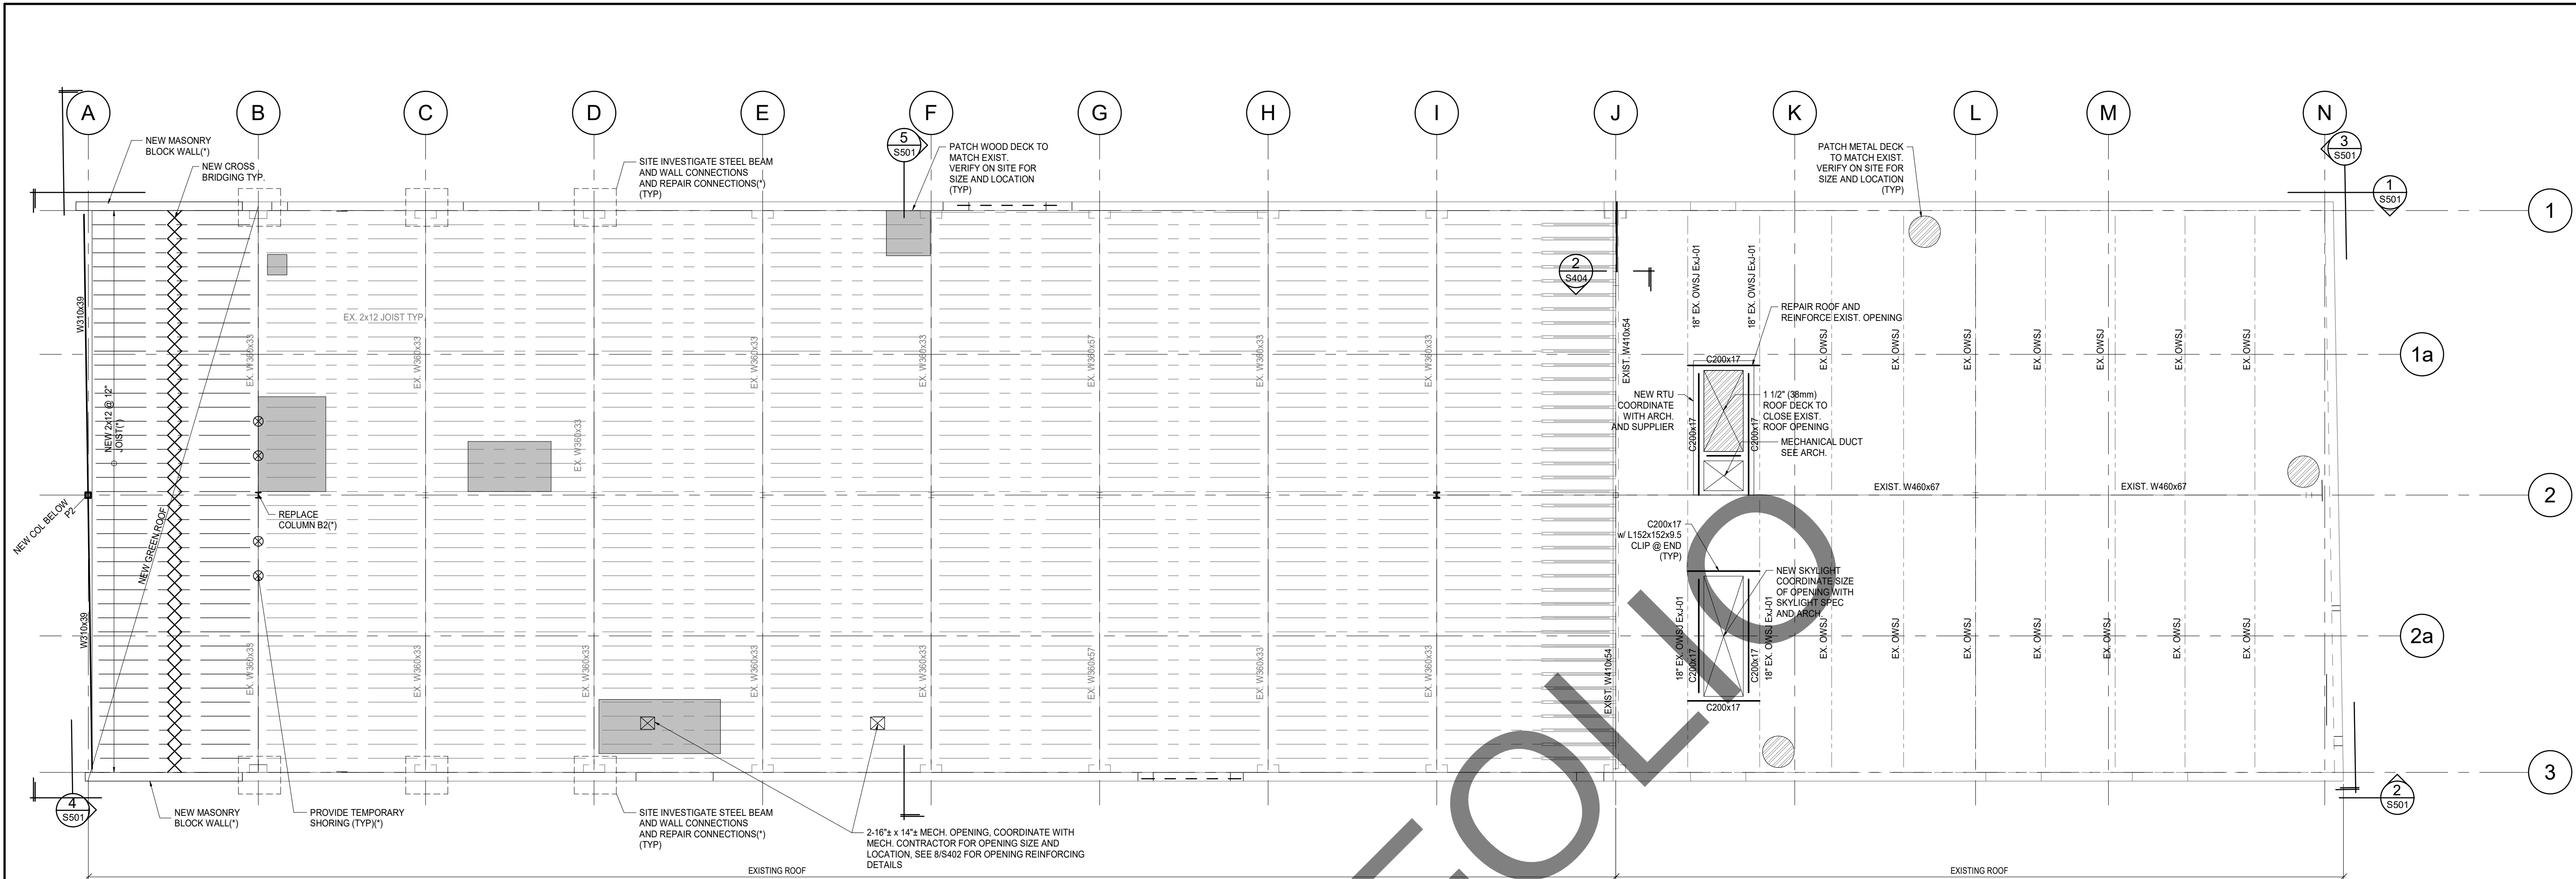

1 ROOF FRAMING PLAN
1/8" = 1'-0"

*** DENOTES: PROVIDE SEPARATE PRICE

NOTES:

- TOP OF EX. JOIST AT EL. 13'-4". TOP OF STEEL AT EL. 13'-1".
- EXTERIOR GREEN ROOF ON EXISTING WOOD ROOF LOADS:
SUPERIMPOSED DEAD LOAD
SLAB SELF WEIGHT = 0.5 kPa
CEILING AND MECHANICAL = 0.3 kPa
SUPERIMPOSED LIVE LOAD = 1.6 kPa
SNOW LOAD-ACCUMULATION(SEE PLAN) = 1.28 kPa

NEW INTERIOR RECREATION AREA ON EXISTING WOOD ROOF LOADS:
SUPERIMPOSED DEAD LOAD
SLAB SELF WEIGHT = 0.2 kPa
CEILING AND MECHANICAL = 0.3 kPa
PARTITION = 0.7 kPa
SUPERIMPOSED LIVE LOAD = 2.4 kPa
- REFER TO ARCHITECTURAL DRAWINGS FOR THE FOLLOWING INFORMATION:
a) ALL FINISHED FLOOR ELEVATIONS
b) LOCATION AND POSITION IN PLAN OF ALL
i) CHANGES IN ELEVATION
ii) SLAB OPENING'S SIZE AND LOCATION
iii) WALL LOCATIONS
c) BUILT UP FLOOR ASSEMBLY
- INSERTS FOR THE ATTACHMENT OF NON-STRUCTURAL ITEMS ARE TO BE SUPPLIED BY THE NON-STRUCTURAL TRADE INVOLVED. LOCATION AND PLACEMENT WITHIN THE CONCRETE STRUCTURE SHALL NOT DISPLACE REINFORCEMENT STEEL. ALL INSERTS NOT SATISFACTORY TO QUINN DRESSSEL ASSOCIATES WILL BE REMOVED AT NO COST.
- SHOP DRAWINGS, SLEEVING DRAWINGS, CONDUIT LAYOUT DRAWINGS AND THE LIKE SHALL ACCURATELY INDICATE THE SIZE, LOCATION AND EXTENT OF SUCH ITEMS. ALL SUCH DRAWINGS SHALL BE SUBMITTED TO THE CONSULTANTS MINIMUM 4 WEEKS PRIOR TO CONCRETE SLAB POURS.
- REFER TO THE FOLLOWING DRAWING SERIES FOR RELATED INFORMATION:
S100 SERIES - GENERAL NOTES AND TYPICAL DETAILS
S300 SERIES - COLUMN & FOOTING SCHEDULES
S400 SERIES - FOUNDATION SECTIONS & DETAILS
S500 SERIES - WALL ELEVATIONS
- ALL EXTERIOR STRUCTURAL STEEL SHALL BE HOT GALVANIZED.
- ADD 14" BENT CLOSURE PLATES TYPICAL WHERE NECESSARY.
- REFER TO ARCH FOR BUILT UP FLOOR ASSEMBLY. BUILT UP FLOOR EXTENTS SHOWN ON PLAN AS SHADED GRAY.

ALL EXISTING INFORMATION SHOWN ON DRAWINGS IS TRANSFERRED FROM EXISTING BASE BUILDING DRAWINGS. CONTRACTOR SHALL BE RESPONSIBLE TO SITE VERIFY THE ACCURACY OF THESE DOCUMENTS WITH AS-BUILT CONDITIONS. ALL DETERMINATION OF EXISTING CONDITIONS MUST BE MADE PRIOR TO ANY STRUCTURAL DEMOLITION. ALL DISCREPANCIES SHALL BE REPORTED TO THE ARCHITECTS OR ENGINEERS.

REVISIONS / ISSUE		
NO.	DATE	ISSUED FOR PERMIT
1	2025-05-21	ISSUED FOR PERMIT
2	2025-07-16	ISSUED FOR UPDATES

DISCLAIMER:
CONTRACTOR IS RESPONSIBLE FOR FIELD VERIFYING ALL DIMENSIONS. ANY DISCREPANCIES SHALL BE REPORTED TO THE ARCHITECT PRIOR TO PROCEEDING WITH THE WORK. DRAWINGS ARE NOT TO BE SCALED.

"ALL DRAWINGS, SPECIFICATIONS AND RELATED DOCUMENTS ARE THE COPYRIGHTED PROPERTY OF THE ARCHITECT AND MUST BE RETURNED UPON REQUEST. REPRODUCTION OF DRAWINGS, SPECIFICATIONS AND RELATED DOCUMENTS IN PART OR WHOLE IS FORBIDDEN WITHOUT THE ARCHITECT'S WRITTEN PERMISSION."

NOTIFY ARCHITECT OF ANY DISCREPANCIES AND WAIT FOR INSTRUCTION PRIOR TO PROCEEDING WITH WORK.

2198 Gerard St E Toronto ON M4E 2C7
[t] 416.686.3624 www.paradigm-ad.com

STAMP:








PROJECT NAME / LOCATION:
100071257 ONTARIO LTD. BUILDING RENOVATION

78 ADVANCE RD,
ETOBICOKE, ON, M8Z 2T7

DRAWING TITLE:
SECOND FLOOR FRAMING PLAN

DRAWN BY: MH	PROJECT NO.: 24-327
CHECKED BY: RY	SCALE: As indicated
	DATE: 2025-07-16
	DRAWING NO.: S201


2025-11-03 1:52:12 PM
C:\Users\ry\OneDrive\Documents\100071257\100071257-24-327-25-07-16-Second Floor Framing Plan.dwg
R:\Projects\100071257\100071257-24-327-25-07-16-Second Floor Framing Plan.dwg

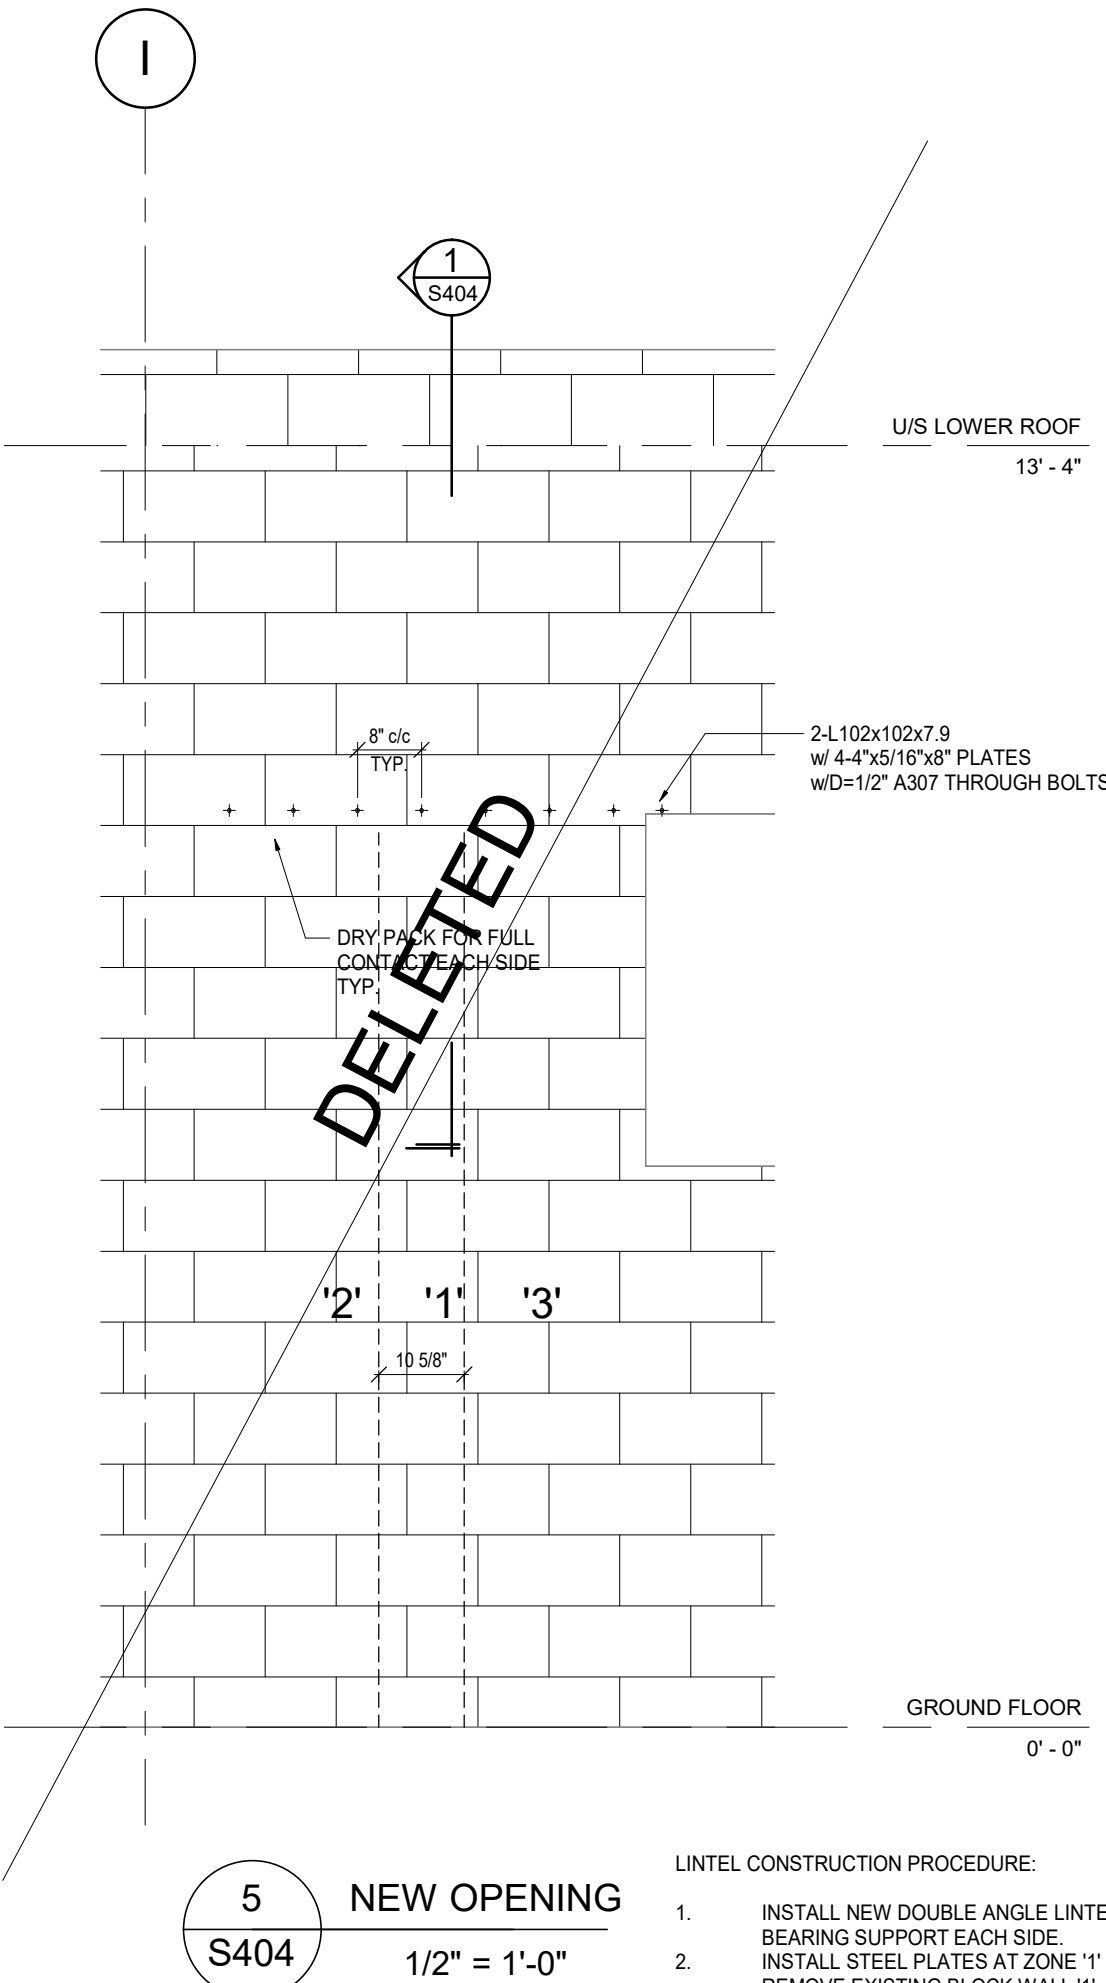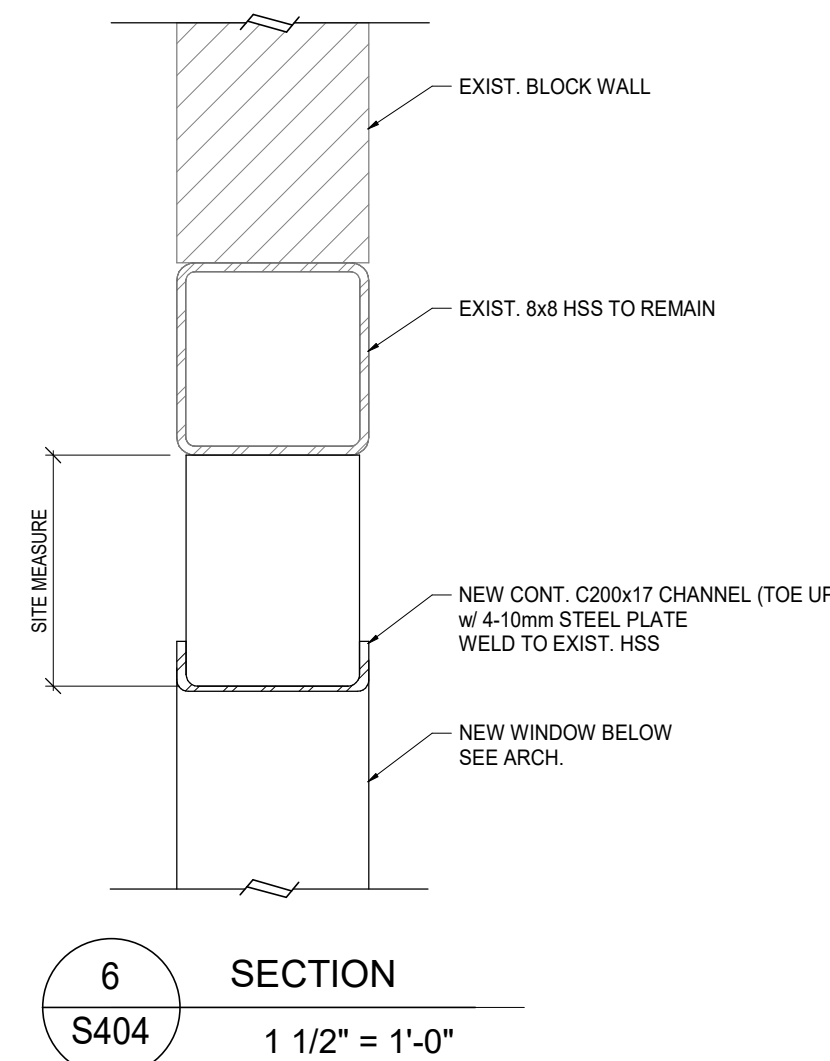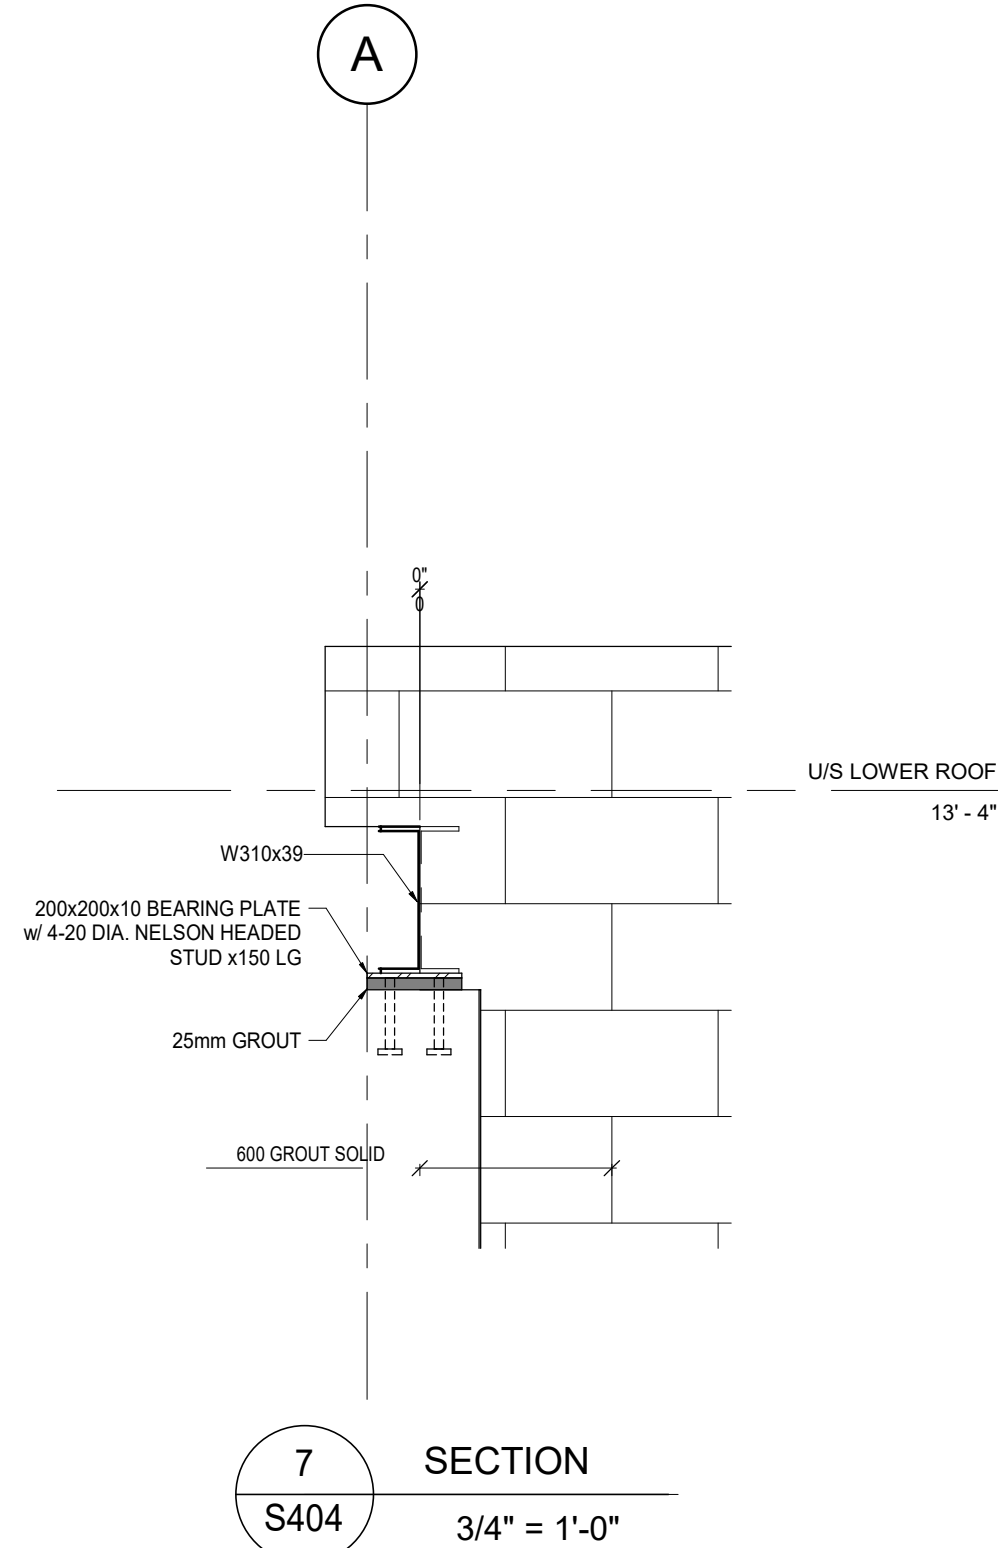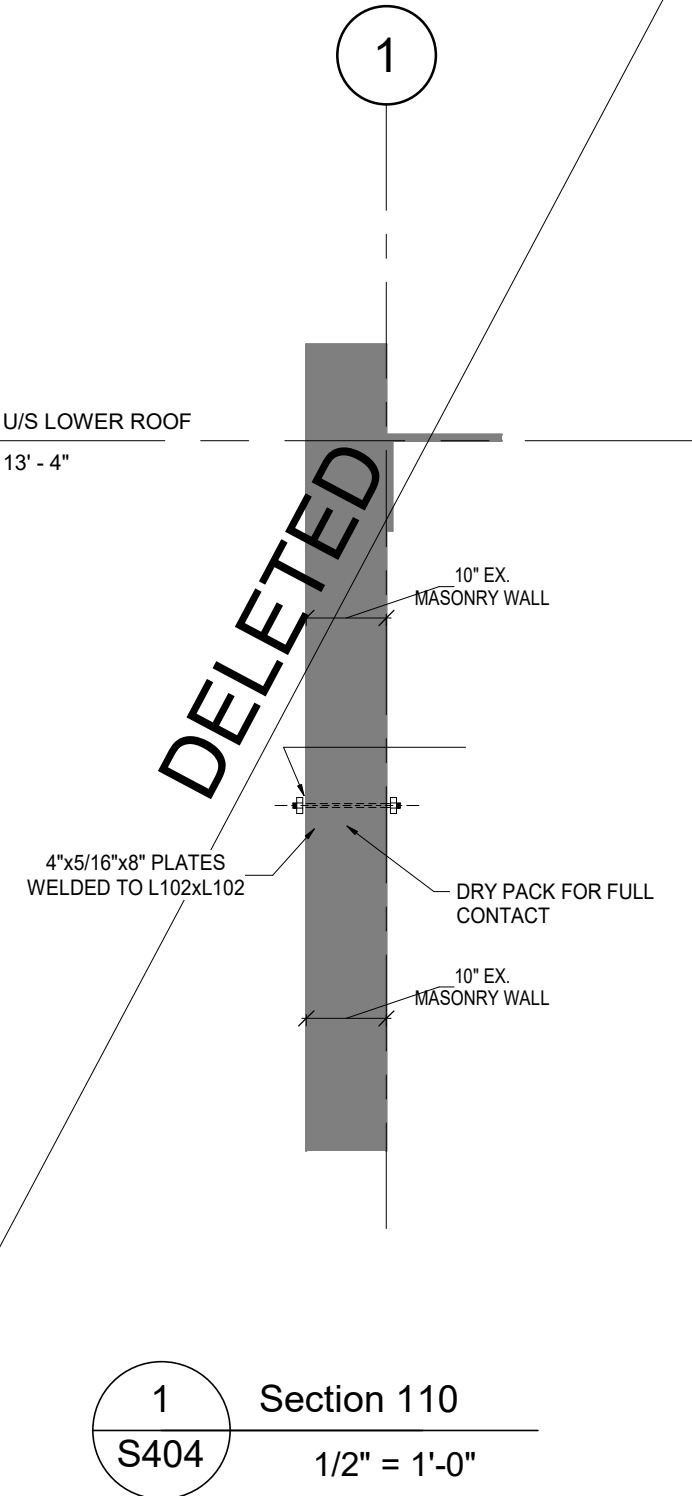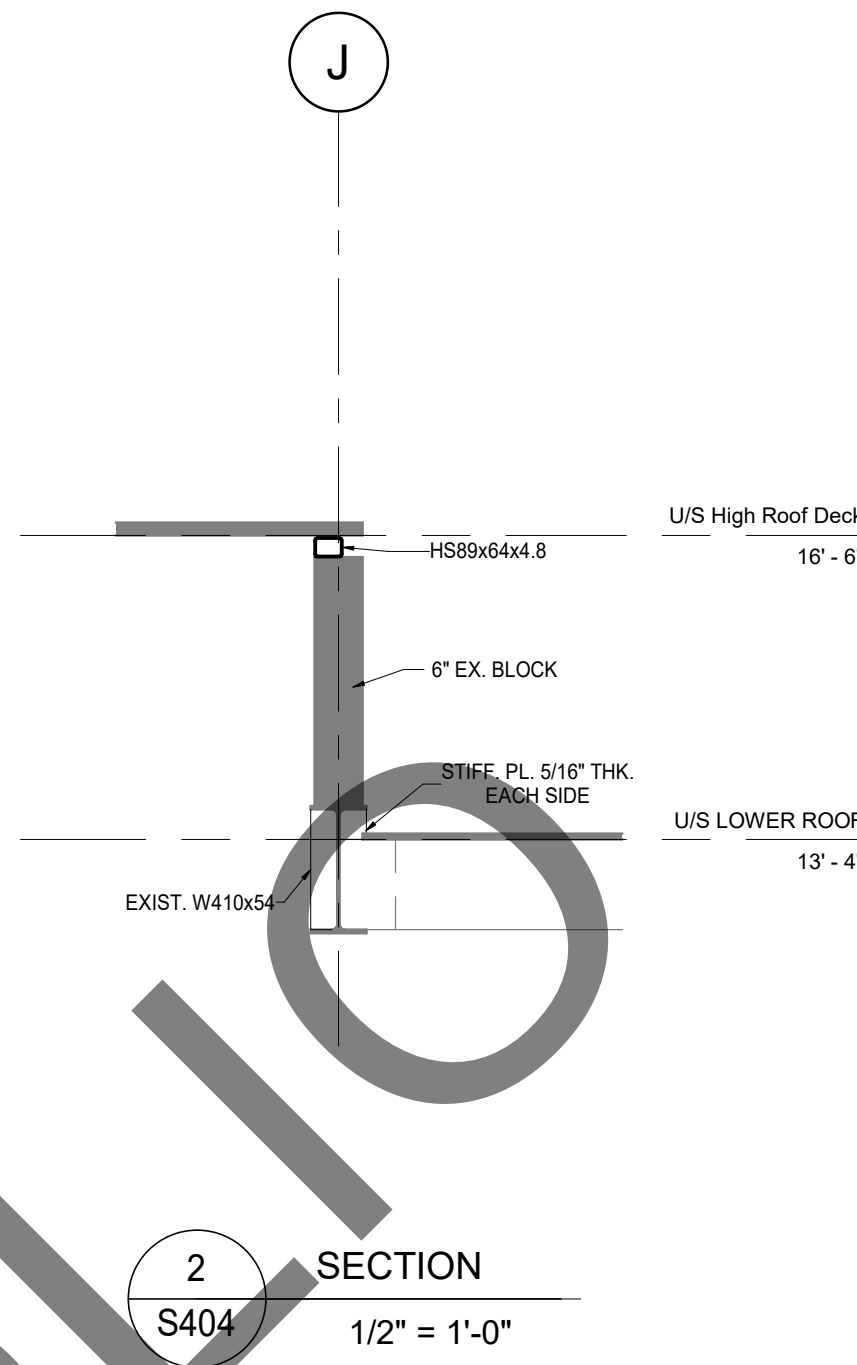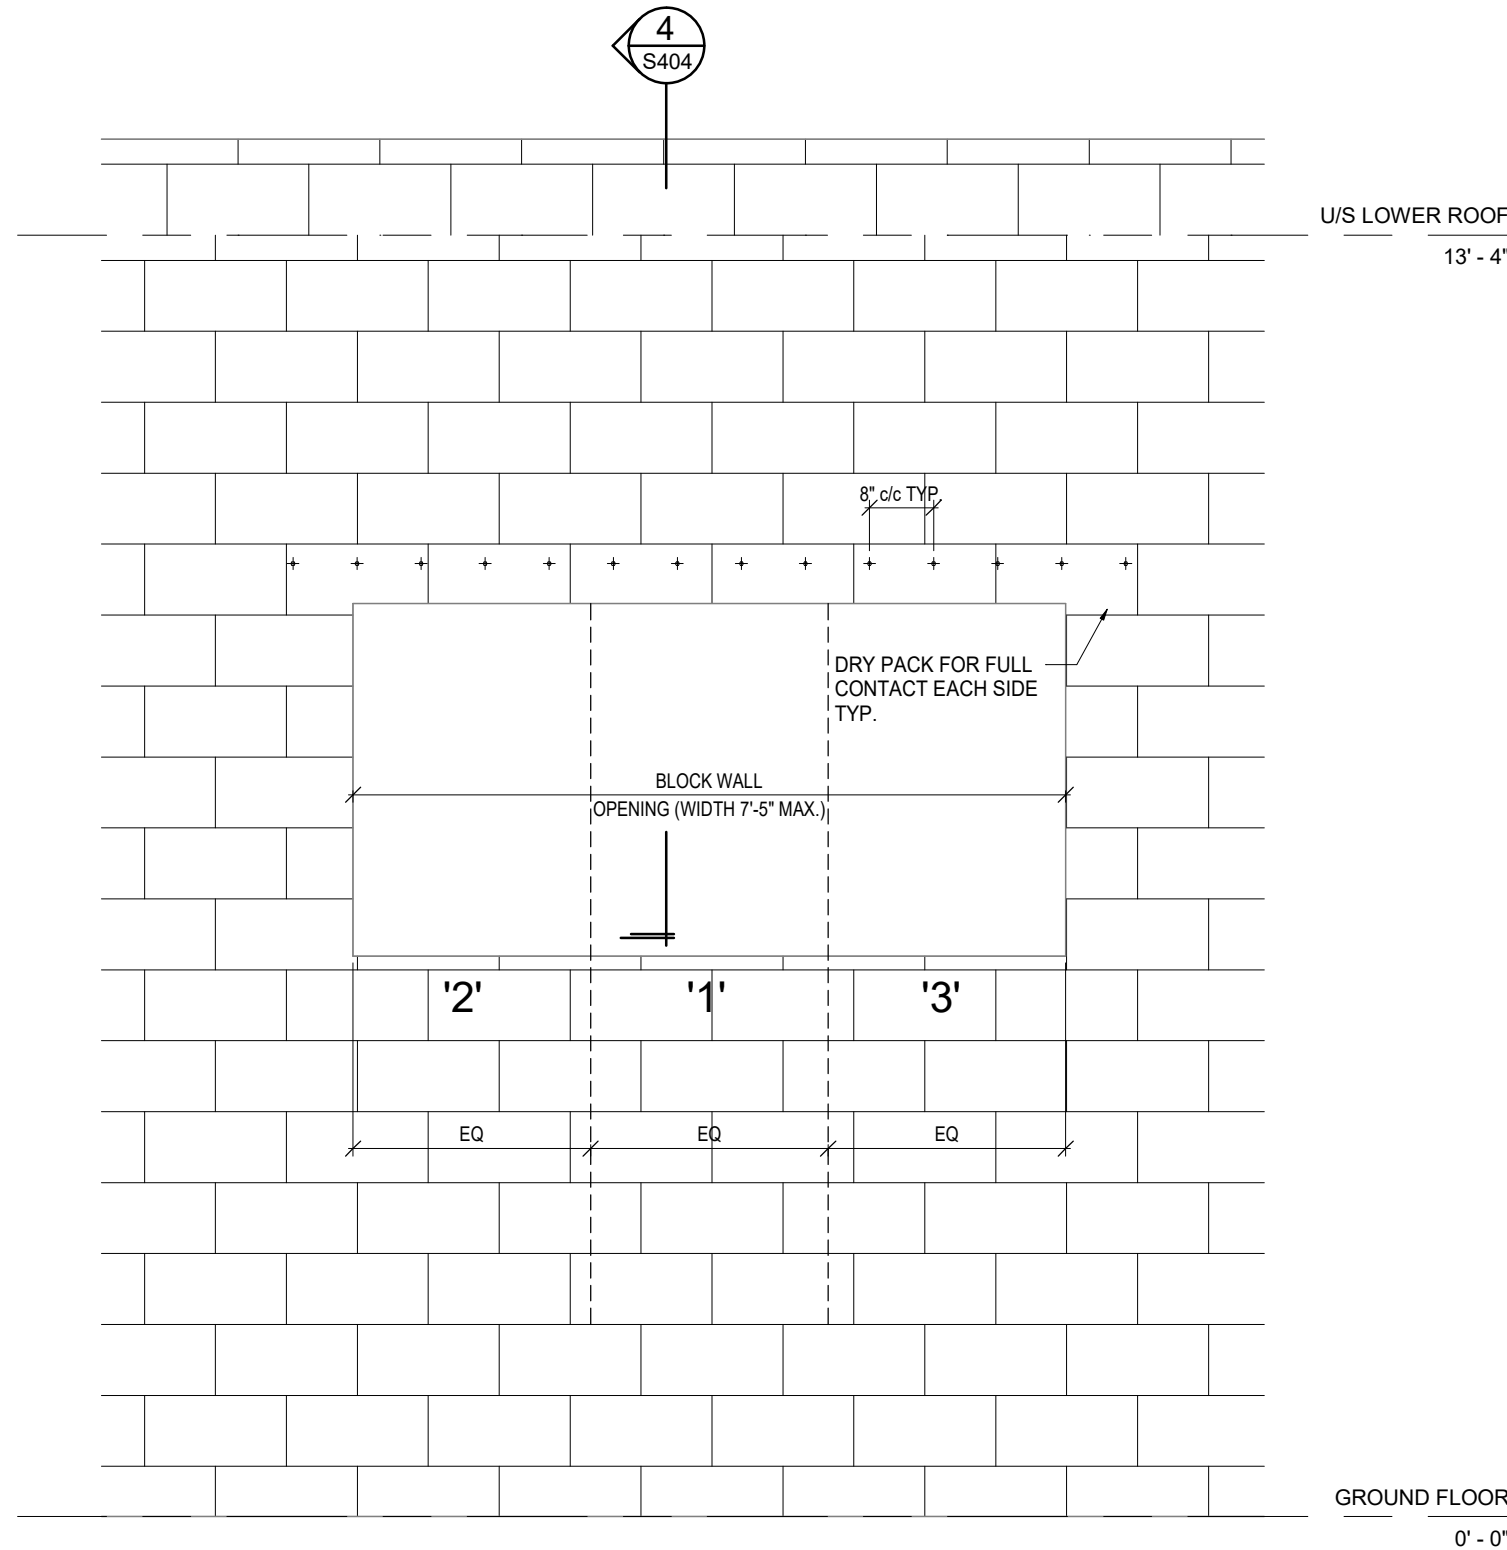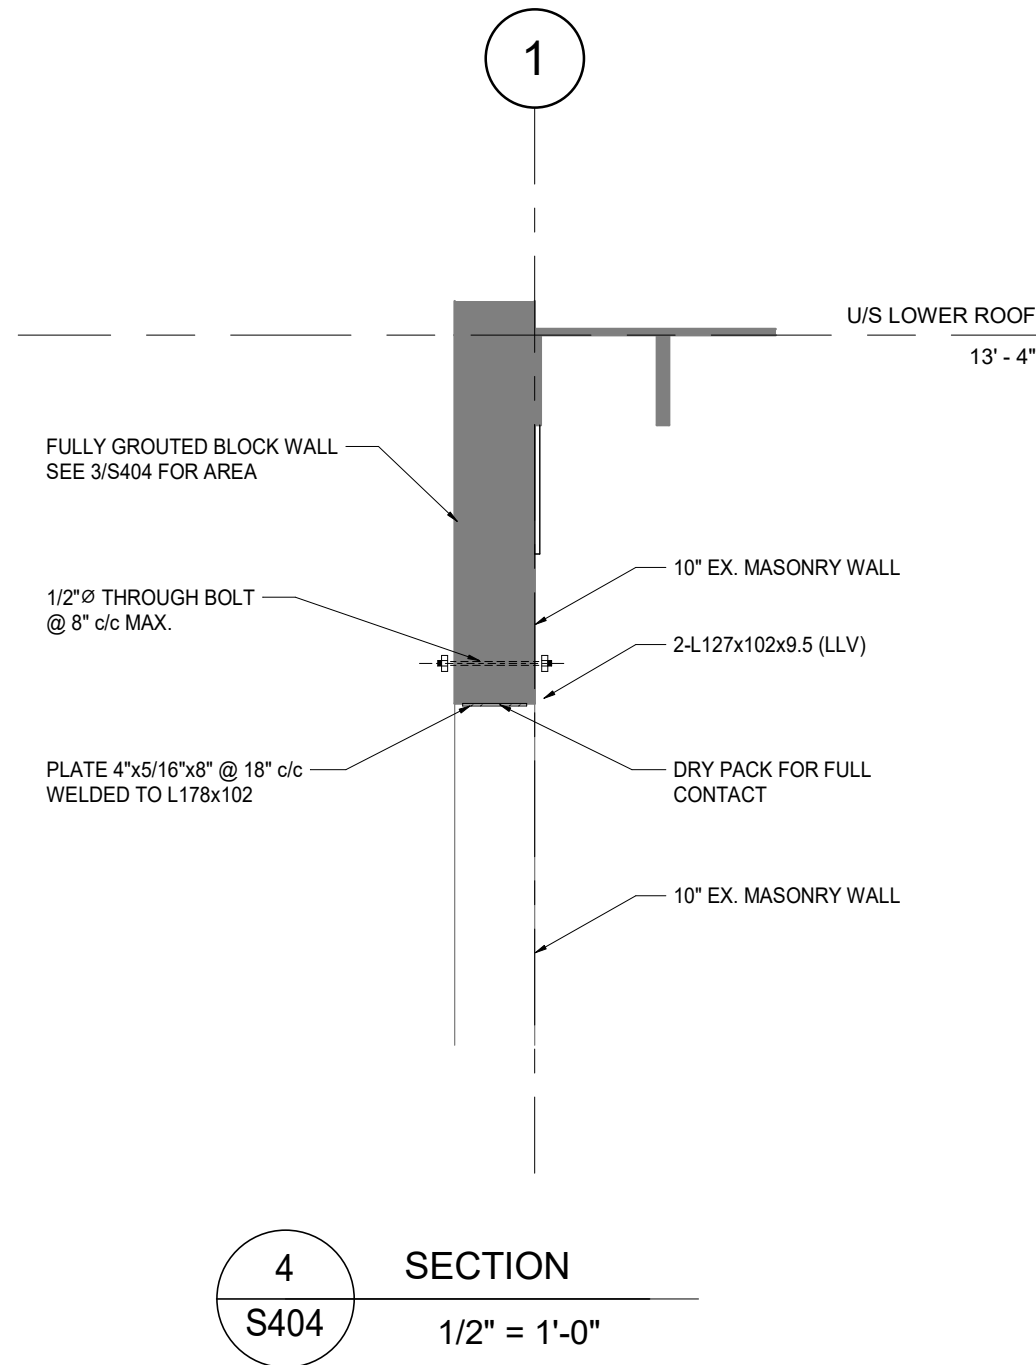


- LINTEL CONSTRUCTION PROCEDURE:
1. INSTALL NEW DOUBLE ANGLE LINTEL WITH FULL CONTACT BEARING SUPPORT EACH SIDE.
 2. INSTALL STEEL PLATES AT ZONE '1' BELOW DOUBLE ANGLE, AND REMOVE EXISTING BLOCK WALL '1'.
 3. INSTALL ALL OTHER STEEL PLATES BELOW DOUBLE ANGLES, THEN REMOVE EXISTING BLOCK WALL '2' AND '3'.

ALL EXISTING INFORMATION SHOWN ON DRAWINGS IS TRANSFERRED FROM EXISTING BASE BUILDING DRAWINGS. CONTRACTOR SHALL BE RESPONSIBLE TO SITE VERIFY THE ACCURACY OF THESE DOCUMENTS WITH AS-BUILT CONDITIONS. ALL DETERMINATION OF EXISTING CONDITIONS MUST BE MADE PRIOR TO ANY STRUCTURAL DEMOLITION. ALL DISCREPANCIES SHALL BE REPORTED TO THE ARCHITECTS OR ENGINEERS.


REVISIONS / ISSUE		
NO.	DATE	REVIEW
1	2024-06-11	ISSUED FOR CLIENT'S REVIEW
2	2024-07-24	ISSUED FOR PERMIT
3	2024-08-24	ISSUED FOR TENDER
4	2025-07-16	ISSUED FOR UPDATES
DISCLAIMER:		
CONTRACTOR IS RESPONSIBLE FOR FIELD VERIFYING ALL DIMENSIONS. ANY DISCREPANCIES SHALL BE REPORTED TO THE ARCHITECT PRIOR TO PROCEEDING WITH THE WORK. DRAWINGS ARE NOT TO BE SCALED.		
"ALL DRAWINGS, SPECIFICATIONS AND RELATED DOCUMENTS ARE THE COPYRIGHTED PROPERTY OF THE ARCHITECT AND MUST BE RETURNED UPON REQUEST. REPRODUCTION OF DRAWINGS, SPECIFICATIONS AND RELATED DOCUMENTS IN PART OR WHOLE IS FORBIDDEN WITHOUT THE ARCHITECT'S WRITTEN PERMISSION."		
NOTIFY ARCHITECT OF ANY DISCREPANCIES AND WAIT FOR INSTRUCTION PRIOR TO PROCEEDING WITH WORK.		
4E M SITE		
Quinn Dressel ASSOCIATES CONSULTING STRUCTURAL ENGINEERS		
FLAT IRON BUILDING GROUP		
paradigm architecture + design 2198 Gerrard St E Toronto ON M4E 2C7 [t] 416.688.3624 www.paradigm-ad.com		
STAMP:		
PROJECT NAME / LOCATION:		
100071257 ONTARIO LTD. BUILDING RENOVATION		
78 ADVANCE RD, ETOBICOKE, ON, M8Z 2T7		
DRAWING TITLE:		
SECOND FLOOR / LOWER ROOF SECTIONS III		
DRAWN BY: DP		PROJECT NO.: 24-327
CHECKED BY: RY		SCALE: As indicated
		DATE: 2025-07-16
		DRAWING NO.: S404

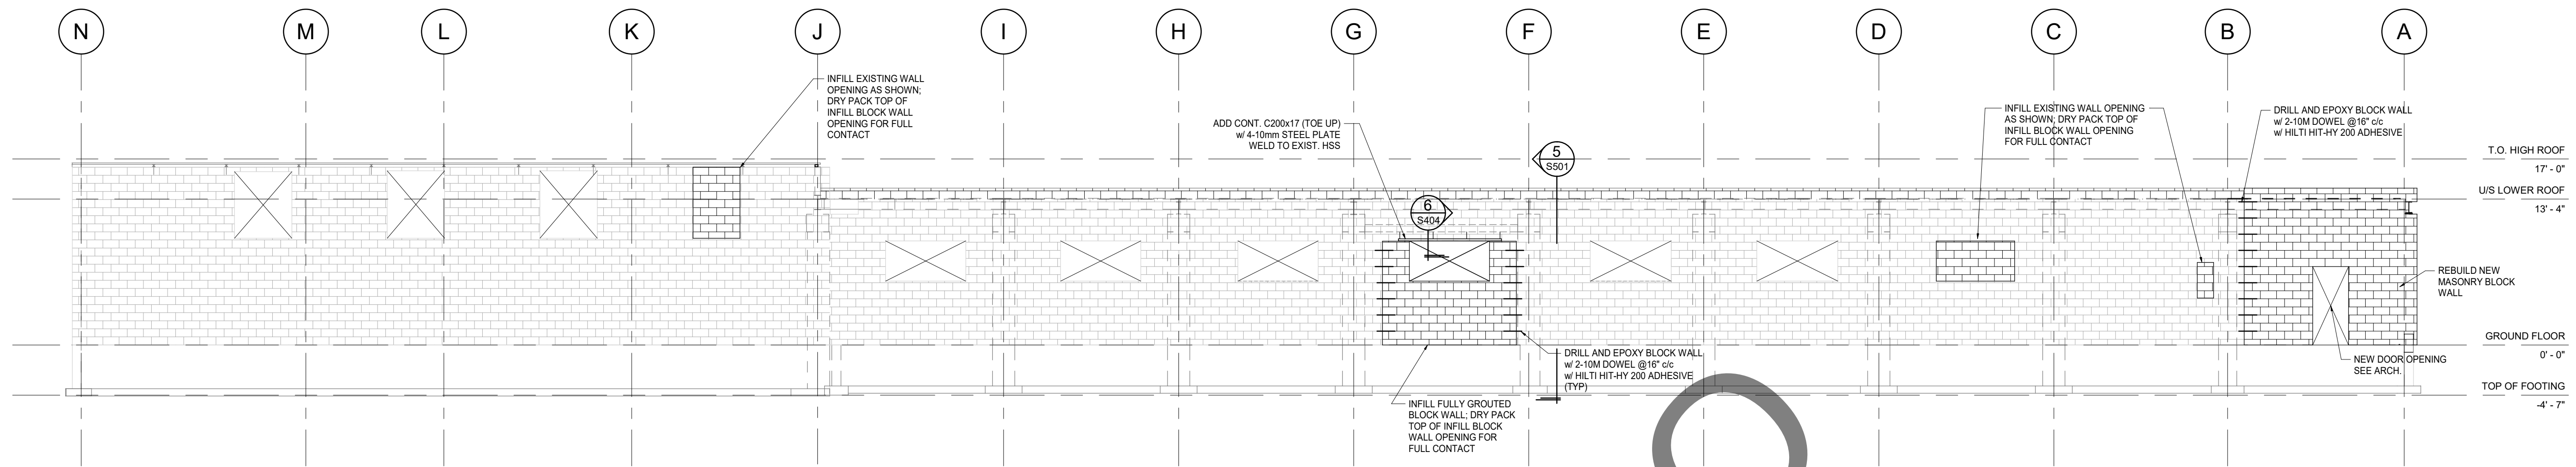


1 WEST ELEVATION
1/8" = 1'-0"

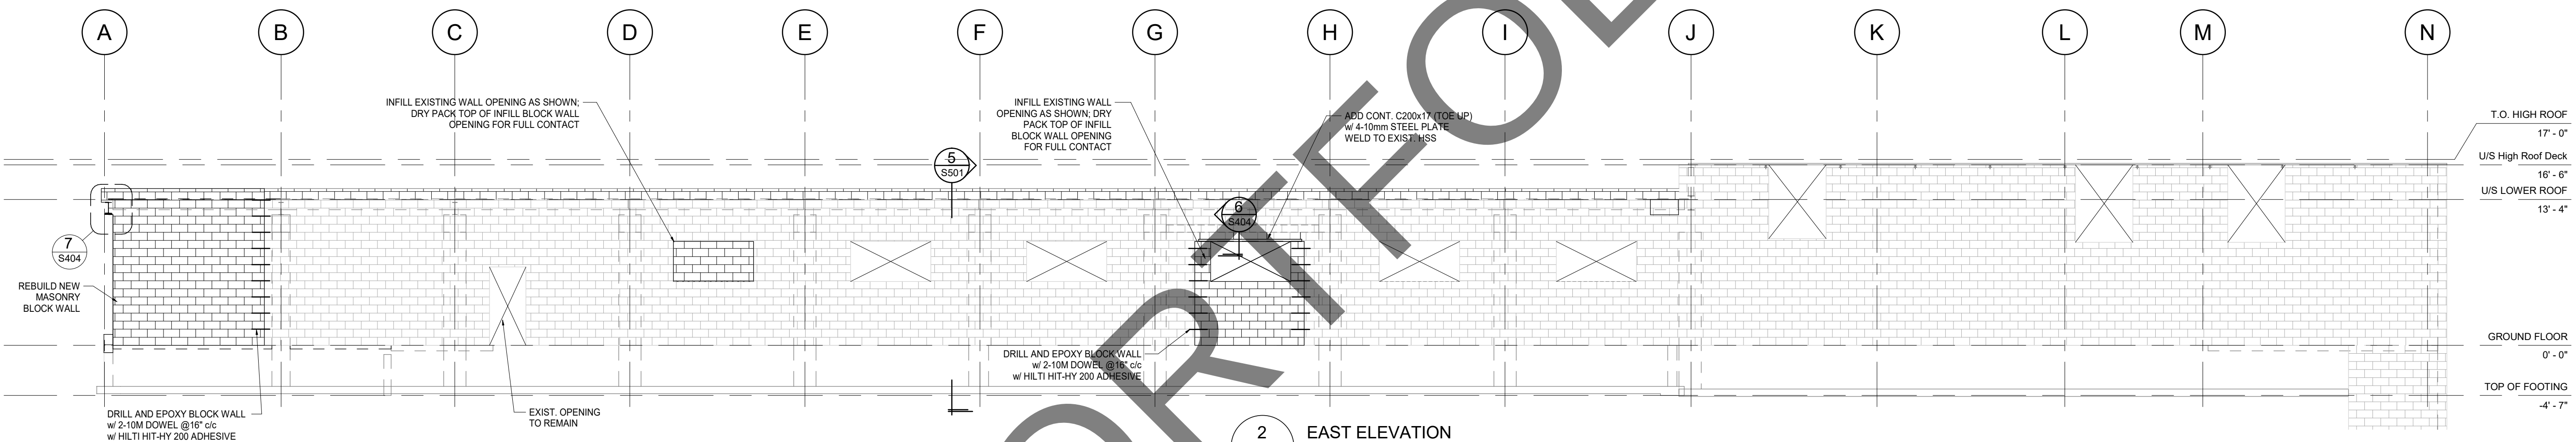


2 EAST ELEVATION
1/8" = 1'-0"

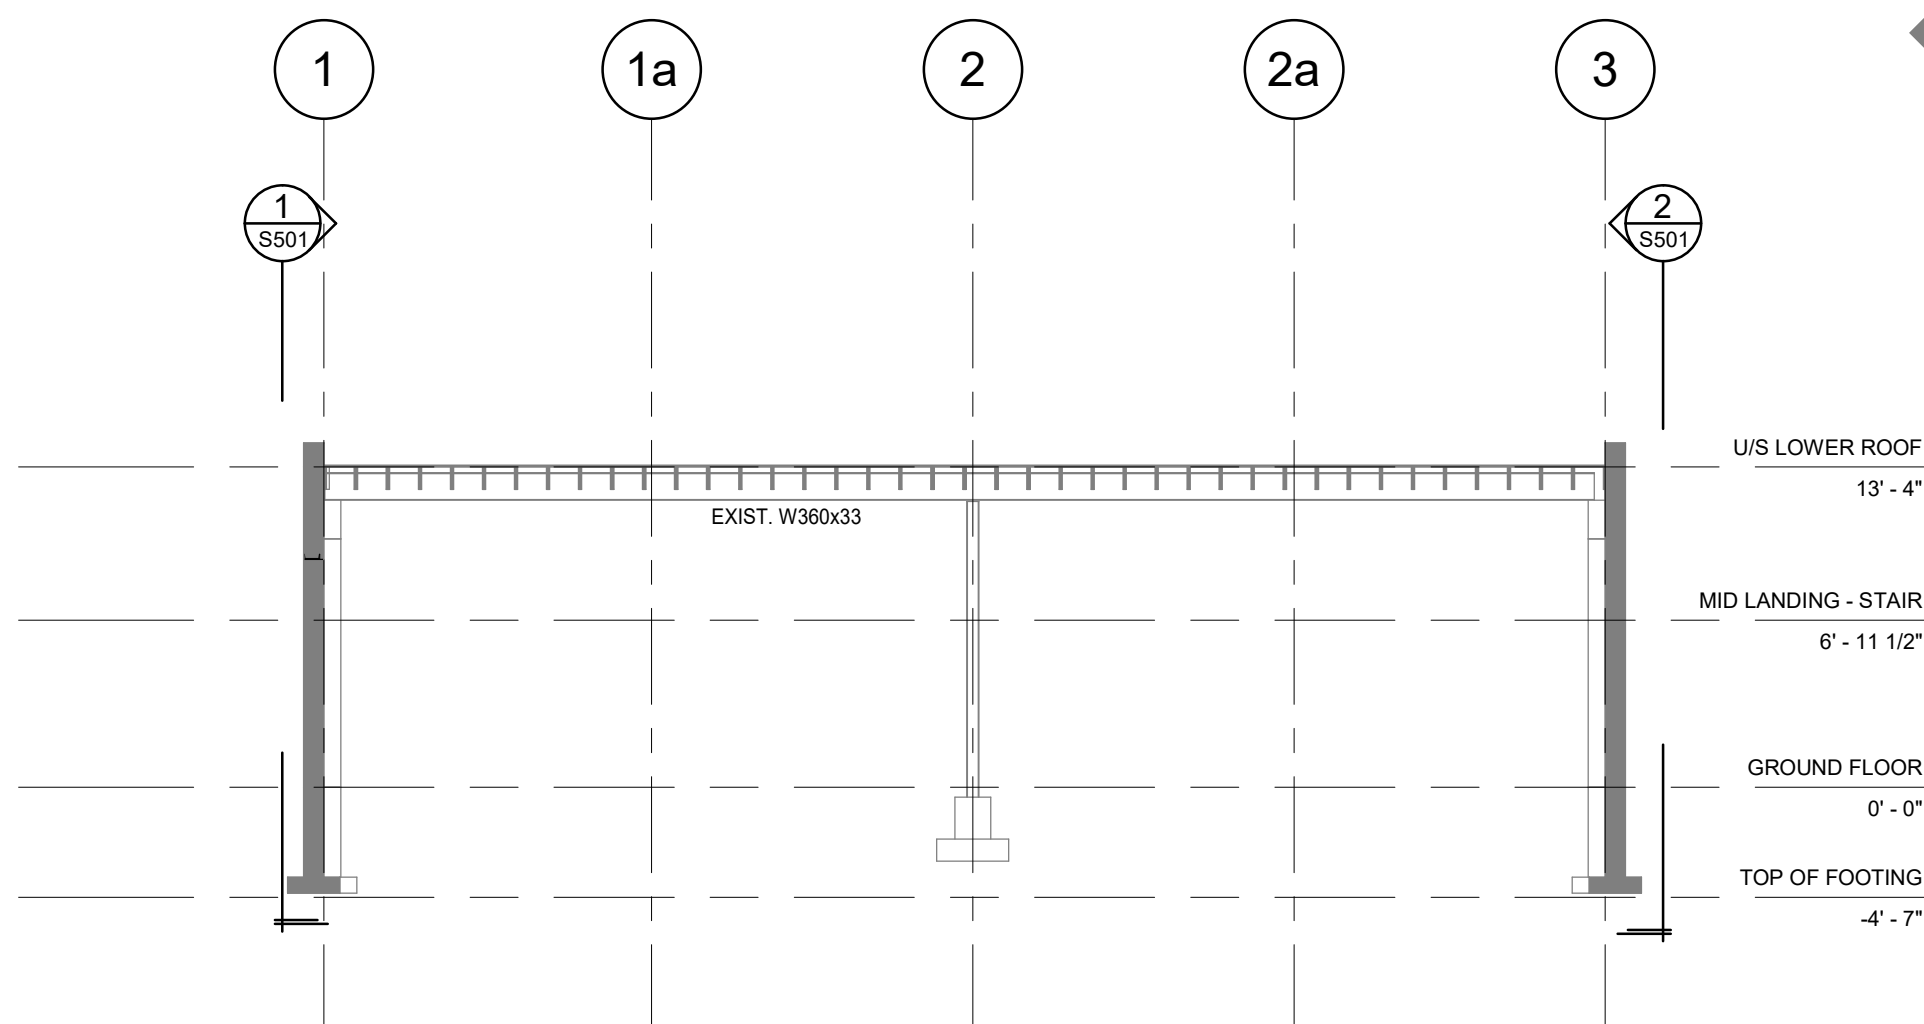

5 SECTION ALONG GRID F
1/8" = 1'-0"

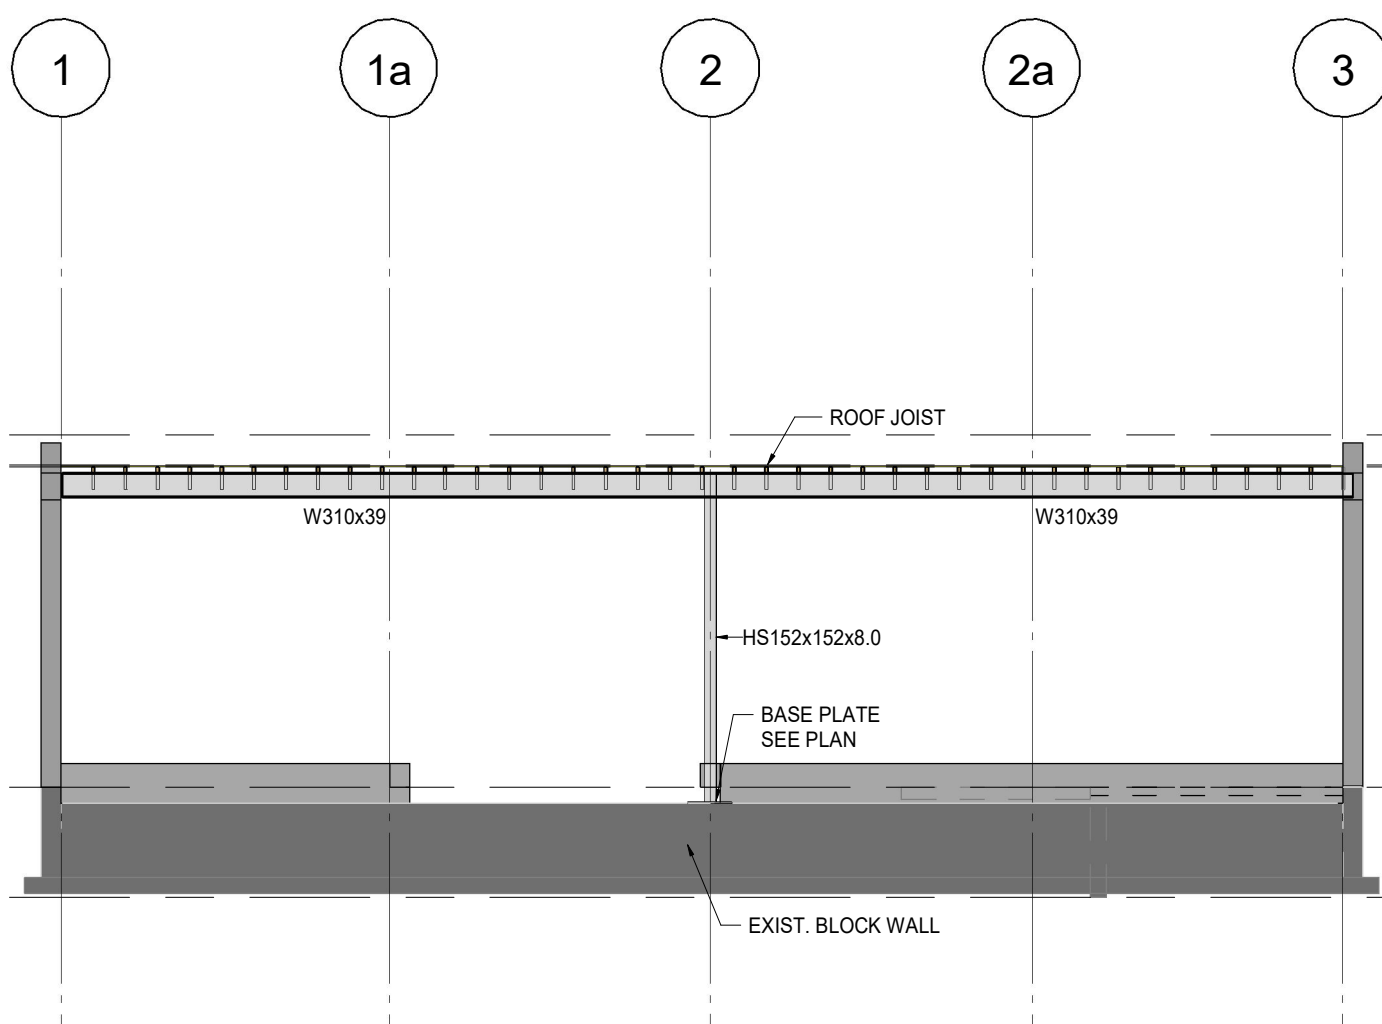

4 SOUTH ELEVATION
1/8" = 1'-0"

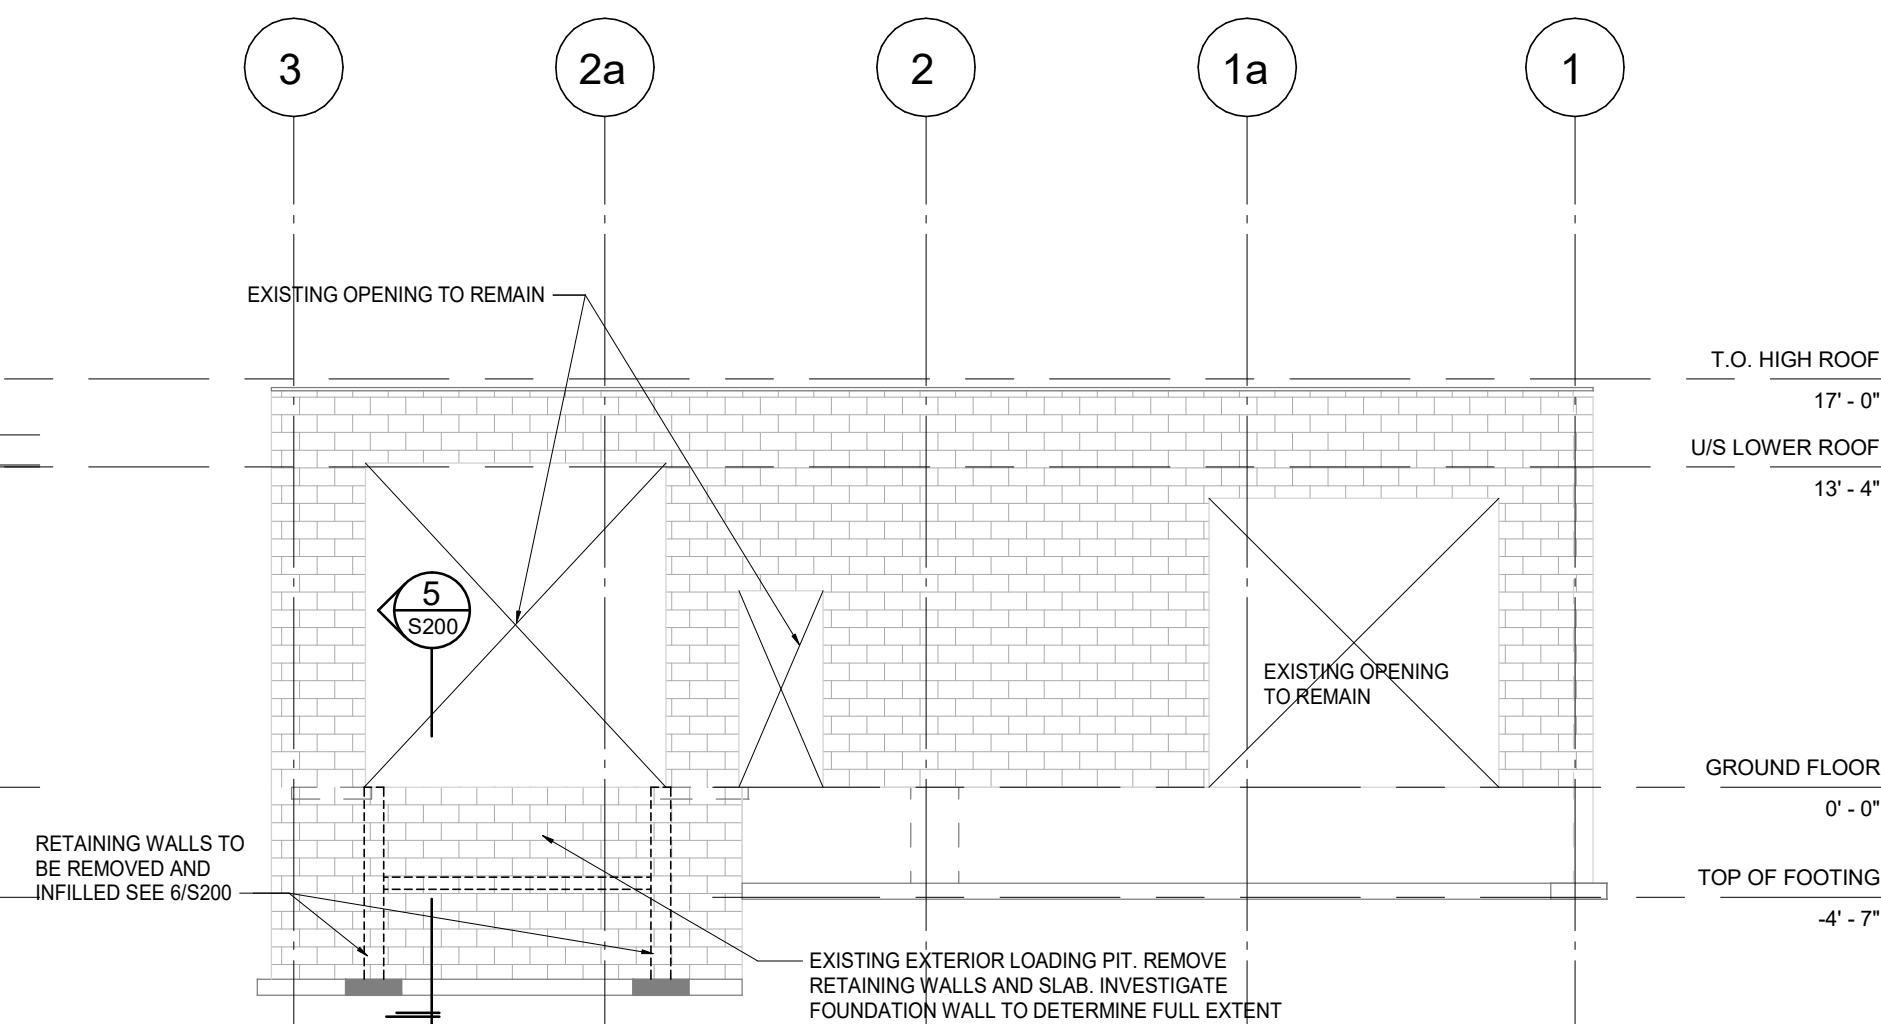

3 NORTH ELEVATION
1/8" = 1'-0"

ALL EXISTING INFORMATION SHOWN ON DRAWINGS IS TRANSFERRED FROM EXISTING BASE BUILDING DRAWINGS. CONTRACTOR SHALL BE RESPONSIBLE TO SITE VERIFY THE ACCURACY OF THESE DOCUMENTS WITH AS-BUILT CONDITIONS. ALL DETERMINATION OF EXISTING CONDITIONS MUST BE MADE PRIOR TO ANY STRUCTURAL DEMOLITION. ALL DISCREPANCIES SHALL BE REPORTED TO THE ARCHITECTS OR ENGINEERS.

REVISIONS / ISSUE		
NO.	DATE	ISSUED FOR
1	2025-05-21	ISSUED FOR PERMIT
2	2025-07-16	ISSUED FOR UPDATES

DISCLAIMER:
CONTRACTOR IS RESPONSIBLE FOR FIELD VERIFYING ALL DIMENSIONS. ANY DISCREPANCIES SHALL BE REPORTED TO THE ARCHITECT PRIOR TO PROCEEDING WITH THE WORK. DRAWINGS ARE NOT TO BE SCALED.
"ALL DRAWINGS, SPECIFICATIONS AND RELATED DOCUMENTS ARE THE COPYRIGHTED PROPERTY OF THE ARCHITECT AND MUST BE RETURNED UPON REQUEST. REPRODUCTION OF DRAWINGS, SPECIFICATIONS AND RELATED DOCUMENTS IN PART OR WHOLE IS FORBIDDEN WITHOUT THE ARCHITECT'S WRITTEN PERMISSION."
NOTIFY ARCHITECT OF ANY DISCREPANCIES AND WAIT FOR INSTRUCTION PRIOR TO PROCEEDING WITH WORK.

PROJECT NAME / LOCATION:
100071257 ONTARIO LTD. BUILDING RENOVATION

78 ADVANCE RD,
ETOBICOKE, ON, M8Z 2T7

DRAWING TITLE:
BUILDING ELEVATIONS

DRAWN BY: DP / TP	PROJECT NO.: 24-327
CHECKED BY: RY	SCALE: As indicated
	DATE: 2025-07-16
	DRAWING NO.: S501

2025-11-03 1:23:30 PM
C:\Users\pdp\OneDrive - Paradigm Architecture\Documents\100071257 Ontario Ltd. Building Renovation\Drawings\100071257 Ontario Ltd. Building Renovation\100071257 Ontario Ltd. Building Renovation.dwg
pdp