


G:\Shared drives\Project Drafting\24-094 G.V Starbucks\Working File\24-094 - G.V Marketplace (Starbucks) R25_Structure.rvt

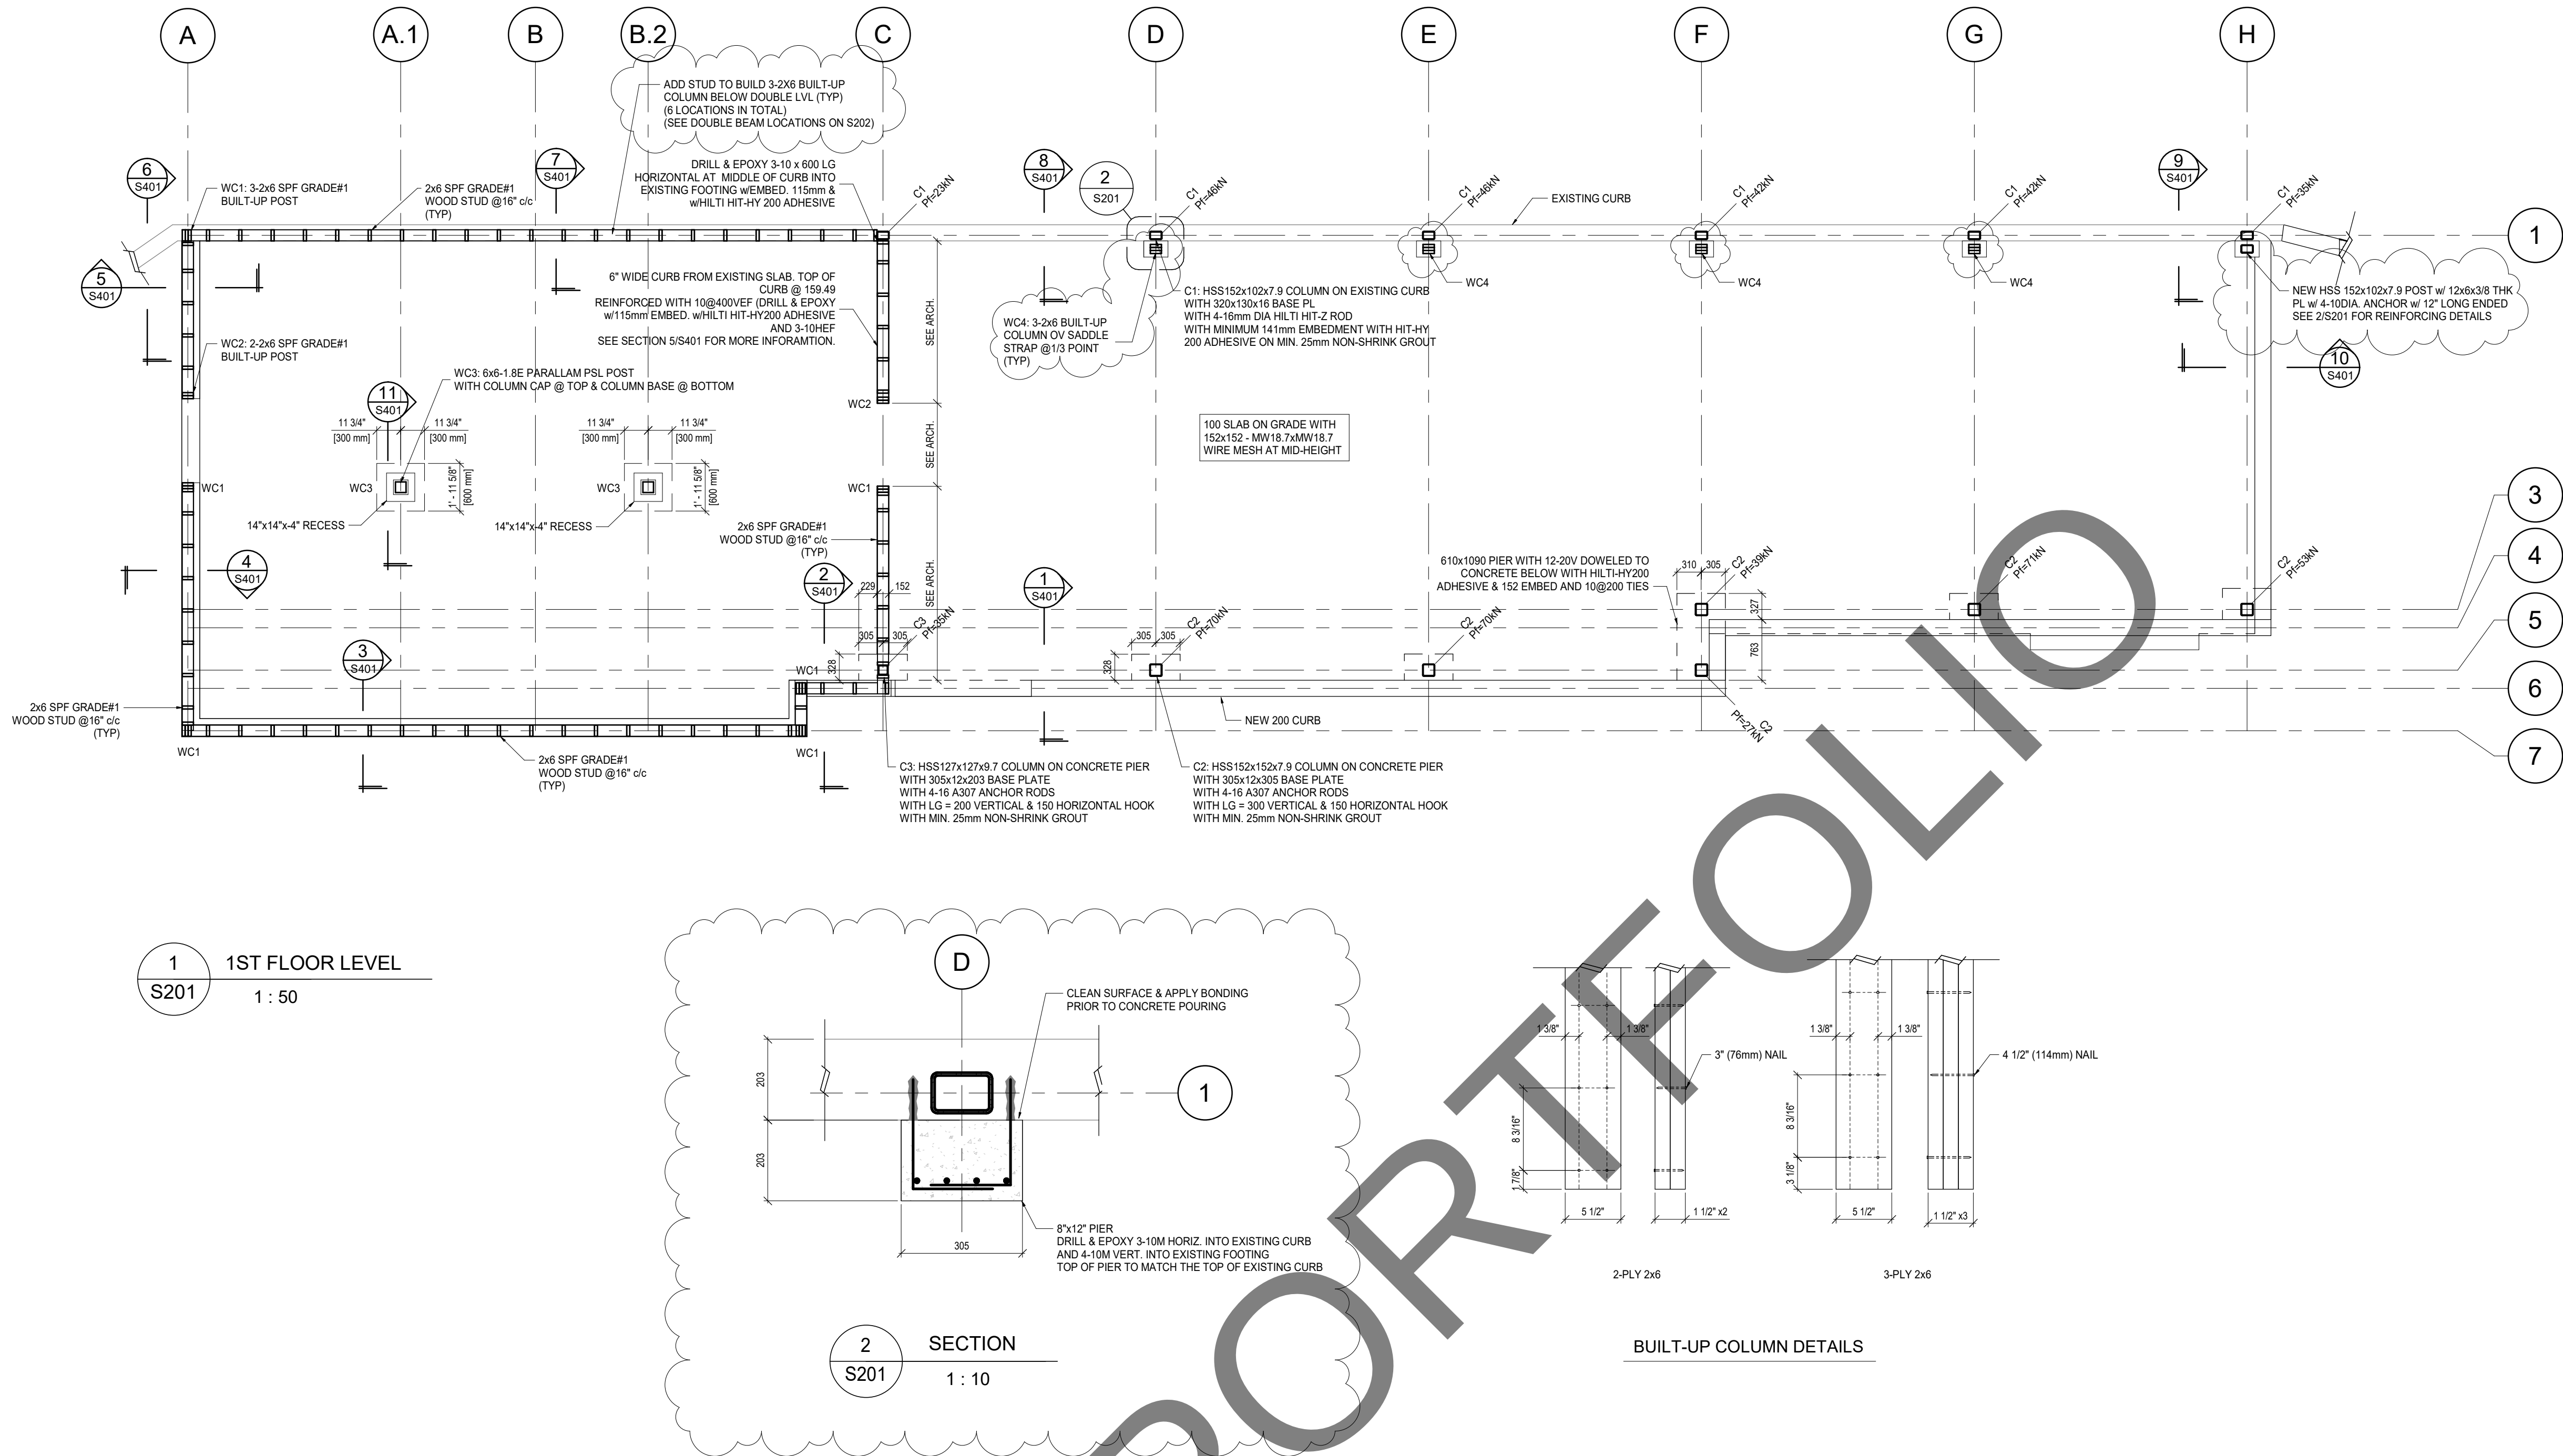

NOTES:
X-RAY OR REBAR SCAN EXISTING CONCRETE SLABS, BEAMS AND COLUMNS TO LOCATE EXISTING REINFORCING STEEL, STIRRUPS, TIES, AND CONDUITS. DO NOT DRILL THROUGH ANY EXISTING REINFORCEMENT AND DO NOT CUT ANY EXISTING CONDUITS.

ALL EXISTING INFORMATION SHOWN ON DRAWINGS IS TRANSFERRED FROM EXISTING BASE BUILDING DRAWINGS. CONTRACTOR SHALL BE RESPONSIBLE TO SITE VERIFY THE ACCURACY OF THESE DOCUMENTS WITH AS-BUILT CONDITIONS. ALL DETERMINATION OF EXISTING CONDITIONS MUST BE MADE PRIOR TO ANY STRUCTURAL DEMOLITION.

1 2024-09-25 ISSUED FOR PERMIT
2 2024-10-28 ISSUED FOR CONSTRUCTION
3 2025-01-23 ISSUED FOR COORDINATION

Quinn Dressel
ASSOCIATES
CONSULTING STRUCTURAL ENGINEERS

RAIMONDO
+ ASSOCIATES
ARCHITECTS INC.

4687 Queen Street Suite 2,
Niagara Falls, ON, L2E 2L9
T | 905-357-4441
F | 905-357-9203
W | www.raidmondarchitects.com
E | mail@raidmondarchitects.com

CLIENT NAME

Niagara Adventure Excursion Inc.

PROJECT NAME

Grand View Marketplace
Starbucks

PROJECT ADDRESS

5920 Niagara River Pkwy, Niagara Falls, ON

SHEET NAME

GROUND FLOOR
FRAMING PLAN

DRAWN BY: JC
DATE: 2025-01-23 10:50:41 AM
SCALE: As indicated
PROJECT NO.: 24-094
CHECKED: RY


DRAWINGS ARE NOT VALID FOR CONSTRUCTION UNTIL SEALED AND SIGNED BY THE ARCHITECT.
DO NOT SCALE DRAWINGS. REPORT ALL DISCREPANCIES TO THE ARCHITECT BEFORE PROCEEDING. ALL DRAWINGS AND DESIGNS REMAIN THE PROPERTY OF THE ARCHITECT, AND ARE PROTECTED UNDER COPYRIGHT.
THESE DESIGN DOCUMENTS ARE PREPARED SOLELY FOR THE USE BY THE PARTY WITH WHOM THE DESIGN PROFESSIONAL HAS ENTERED INTO A CONTRACT AND THERE ARE NO REPRESENTATIONS OF ANY KIND MADE BY THE DESIGN PROFESSIONAL TO ANY PARTY WITH WHOM THE DESIGN PROFESSIONAL HAS NOT ENTERED INTO A CONTRACT.

SHEET #

S201

REV. #

G:\Shared drives\Project Drafting\24-094 G.V.Starbucks\Working File\24-094 - G.V. Marketplace (Starbucks) R25_Structure.rvt

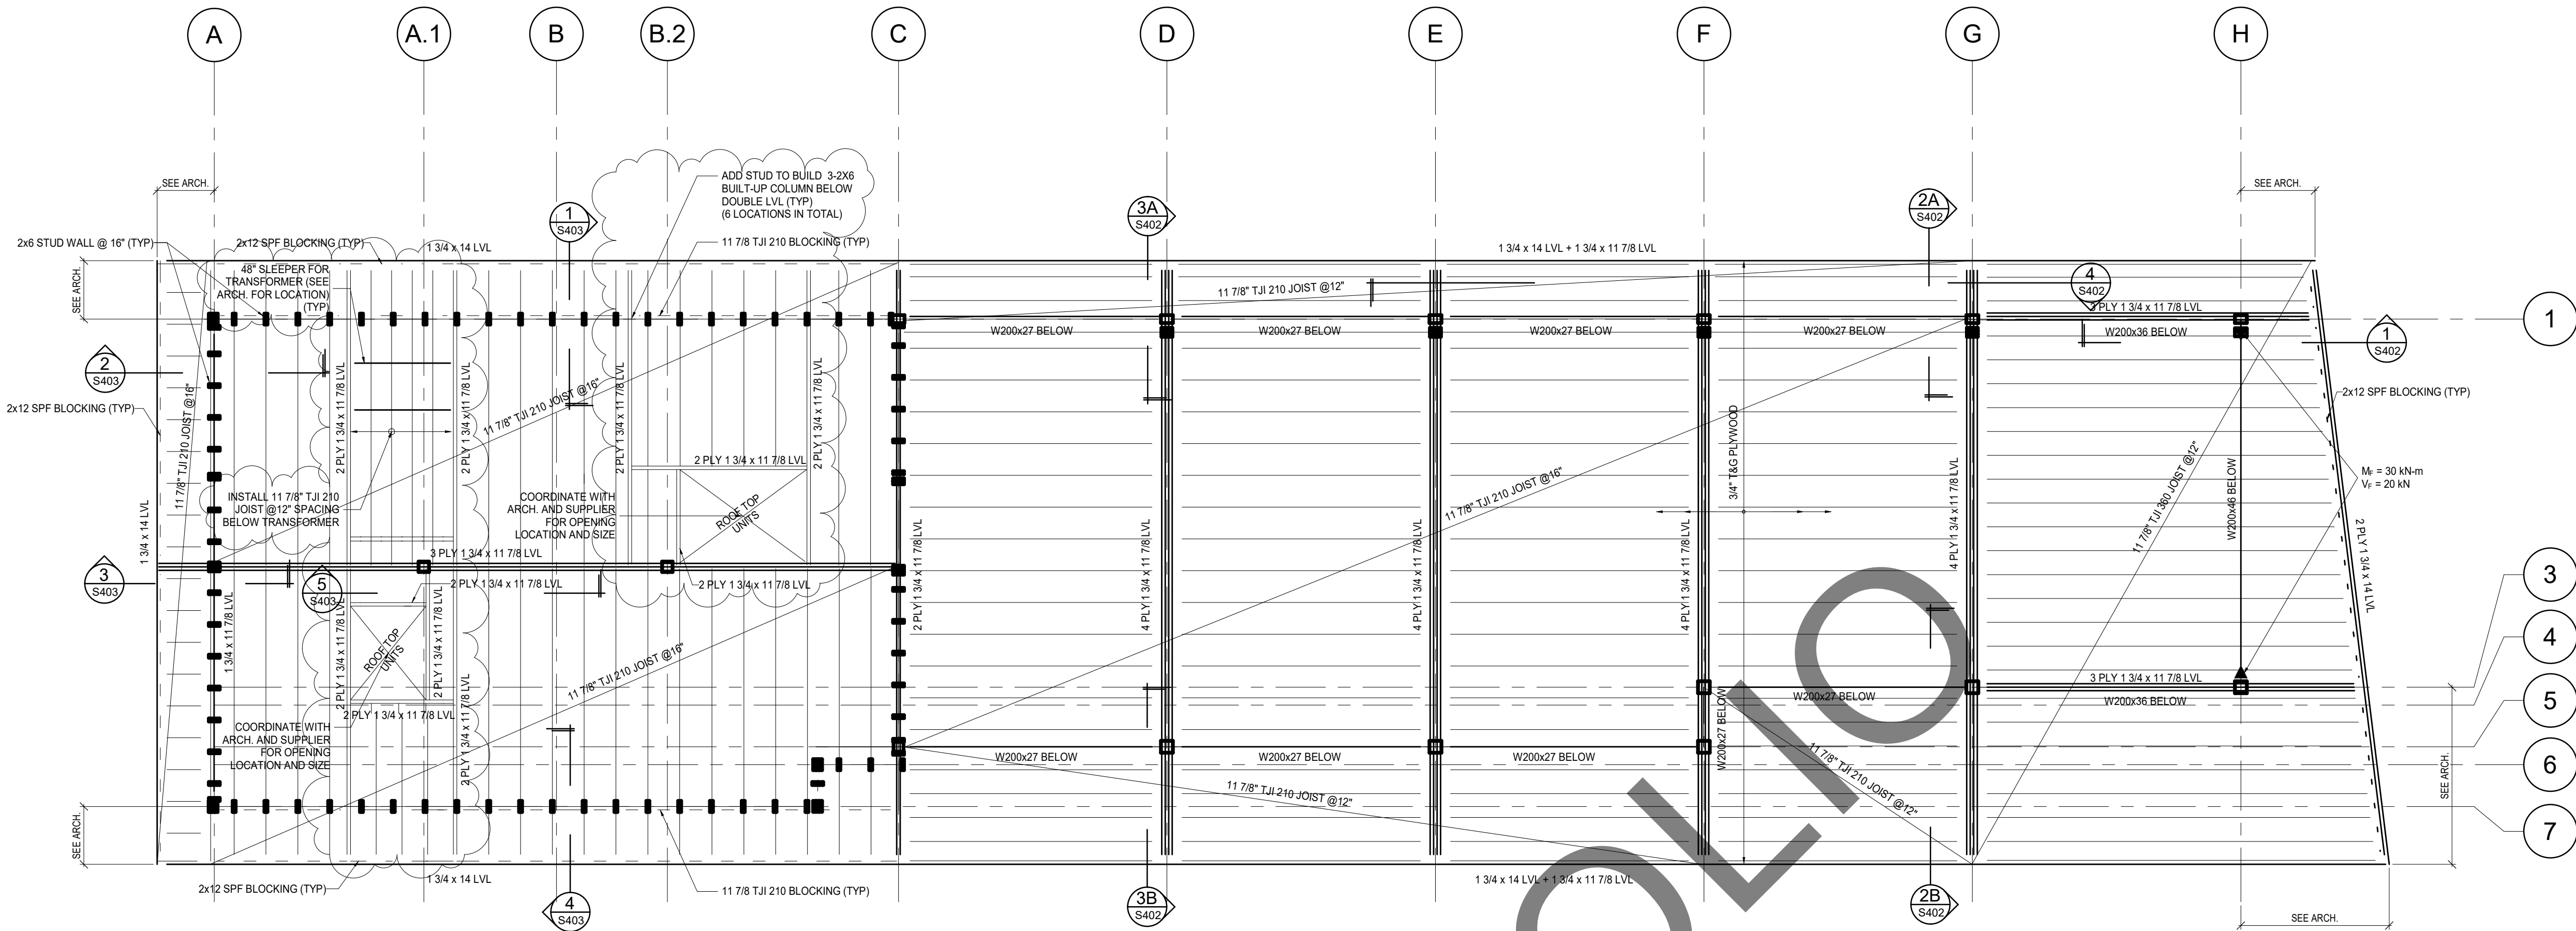

1 ROOF FRAMING
S202 1 : 50

- NOTES:
- TOP OF TJI JOIST IS AT 163.35m UNLESS NOTED OTHERWISE.
 - ROOF DESIGN LOADS:
SUPERIMPOSED DEAD:
SELF WEIGHT:
ROOFING: 0.1KPA (2LBS/FT²)
CEILING E&M : 0.3KPA (6.5LBS/FT²)
LIVE LOAD: 0.5KPA (10LBS/FT²)
SNOW LOAD: 1.9KPA (40LBS/FT²)
 - ROOF TOP UNITS SEE PLAN:
A. TRANSFORMER: 1200LBS
B. AHU
 - REFER TO ARCHITECTURAL DRAWINGS FOR THE FOLLOWING INFORMATION:
A. ALL FINISHED FLOOR ELEVATIONS
B. LOCATION AND POSITION IN PLAN OF ALL
a. CHANGES IN ELEVATION
b. SLAB OPENING'S SIZE AND LOCATION
c. WALL LOCATIONS
 - INSERTS FOR THE ATTACHMENT OF NON-STRUCTURAL ITEMS ARE TO BE SUPPLIED BY THE NON-STRUCTURAL TRADE INVOLVED. LOCATION AND PLACEMENT WITHIN THE CONCRETE STRUCTURE SHALL NOT DISPLACE REINFORCEMENT STEEL. ALL INSERTS NOT SATISFACTORY TO QUINN DRESSSEL ASSOCIATES WILL BE REMOVED AT NO COST.
 - SHOP DRAWINGS, SLEEVING DRAWINGS, CONDUIT LAYOUT DRAWINGS AND THE LIKE SHALL ACCURATELY INDICATE THE SIZE LOCATION AND EXTENT OF SUCH ITEMS. ALL SUCH DRAWINGS SHALL BE SUBMITTED TO THE CONSULTANTS MINIMUM 4 WEEKS PRIOR TO CONCRETE SLAB POURS.

1 2024-09-25 ISSUED FOR PERMIT
2 2024-10-28 ISSUED FOR CONSTRUCTION
3 2025-01-23 ISSUED FOR COORDINATION

Quinn Dressel
ASSOCIATES
CONSULTING STRUCTURAL ENGINEERS

RAIMONDO
+ ASSOCIATES
ARCHITECTS INC.

4687 Queen Street Suite 2,
Niagara Falls, ON, L2E 2L9
T | 905-357-4441
F | 905-357-9203
W | www.raidmondarchitects.com
E | mail@raidmondarchitects.com

CLIENT NAME
Niagara Adventure Excursion Inc.

PROJECT NAME
Grand View Marketplace
Starbucks

PROJECT ADDRESS
5920 Niagara River Pkwy, Niagara Falls, ON

SHEET NAME
ROOF PLAN

DRAWN BY: JC
DATE: 2025-01-23 10:50:43 AM
SCALE: As indicated
PROJECT NO.: 24-094
CHECKED: RY

DRAWINGS ARE NOT VALID FOR CONSTRUCTION UNTIL SEALED AND
SIGNED BY THE ARCHITECT.

DO NOT SCALE DRAWINGS. REPORT ALL DISCREPANCIES TO THE
ARCHITECT BEFORE PROCEEDING. ALL DRAWINGS AND DESIGNS
REMAIN THE PROPERTY OF THE ARCHITECT, AND ARE PROTECTED
UNDER COPYRIGHT.


THESE DESIGN DOCUMENTS ARE PREPARED SOLELY FOR THE USE
BY THE PARTY WITH WHOM THE DESIGN PROFESSIONAL HAS
ENTERED INTO A CONTRACT AND THERE ARE NO REPRESENTATIONS
OF ANY KIND MADE BY THE DESIGN PROFESSIONAL TO ANY PARTY
WITH WHOM THE DESIGN PROFESSIONAL HAS NOT ENTERED INTO A
CONTRACT.

SHEET #


S202

REV. #


G:\Shared drives\Project Drafting\24-094 G.V Starbucks\Working File\24-094 - NAE - G.V Marketplace (Starbucks) R25_Structure.rvt

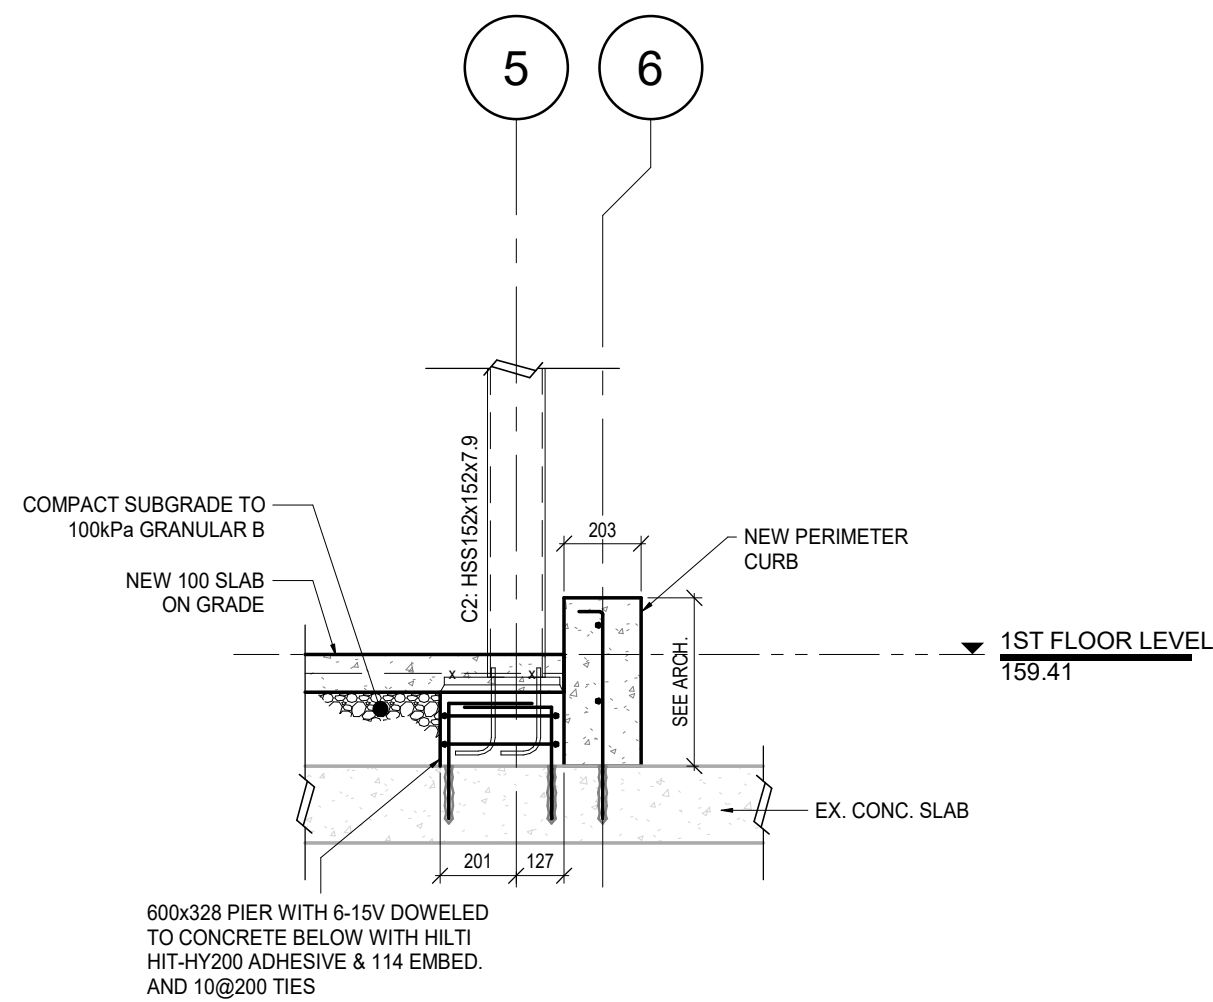


1 SECTION
S401 1 : 20

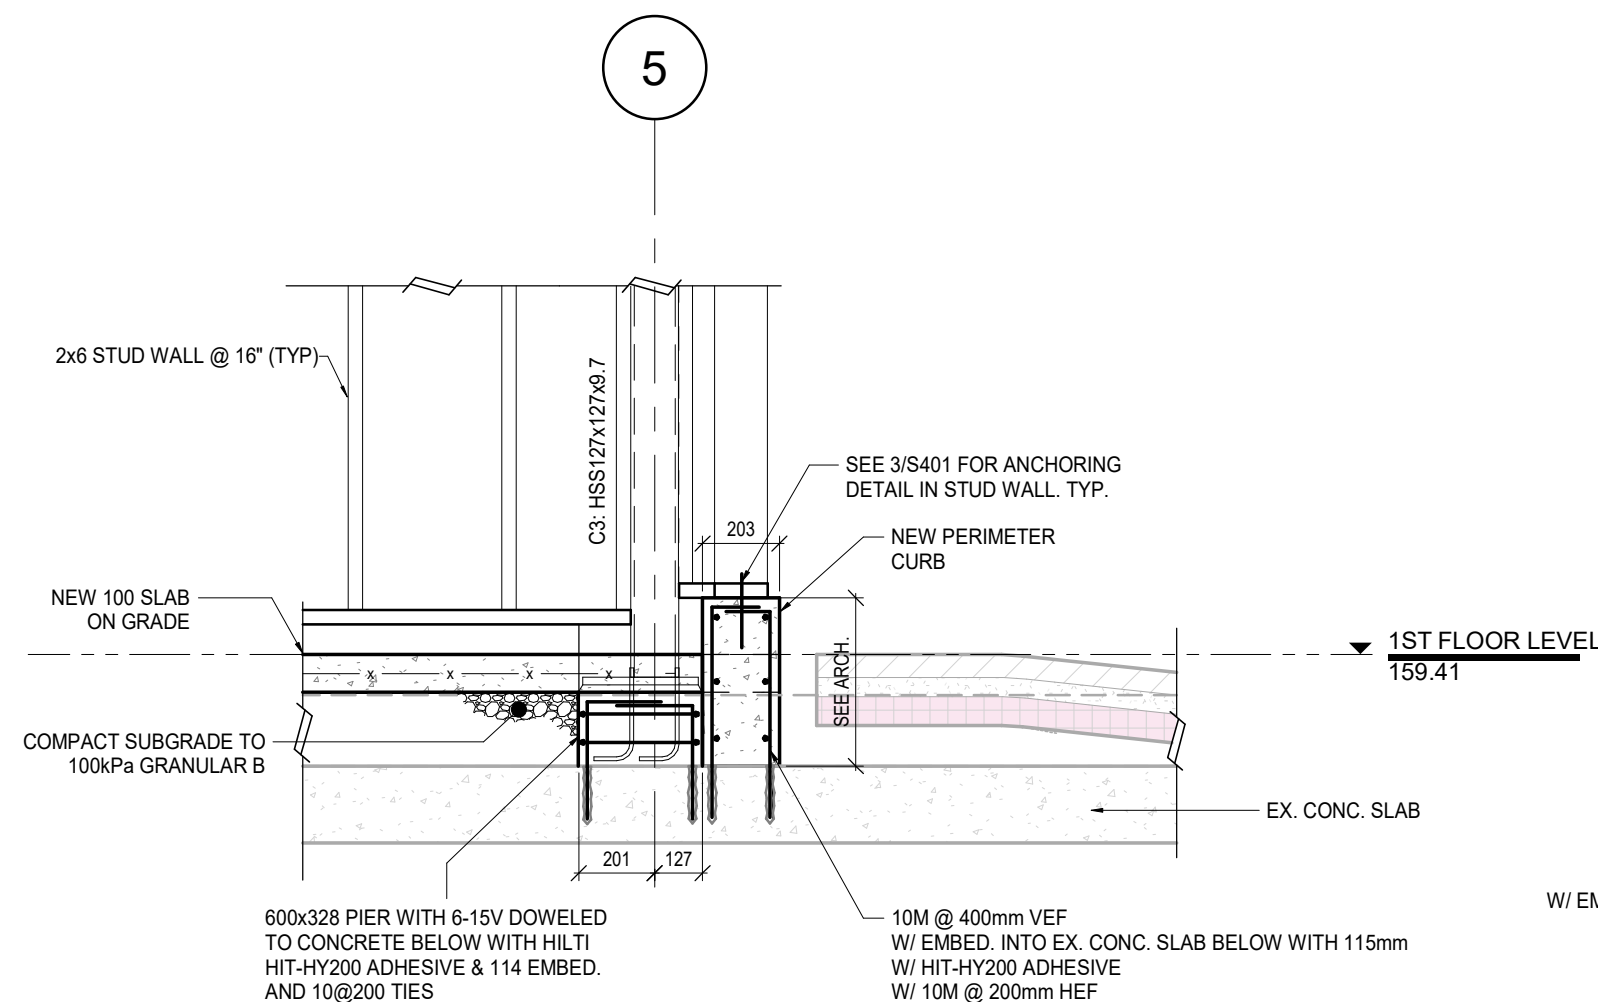


2 SECTION
S401 1 : 20

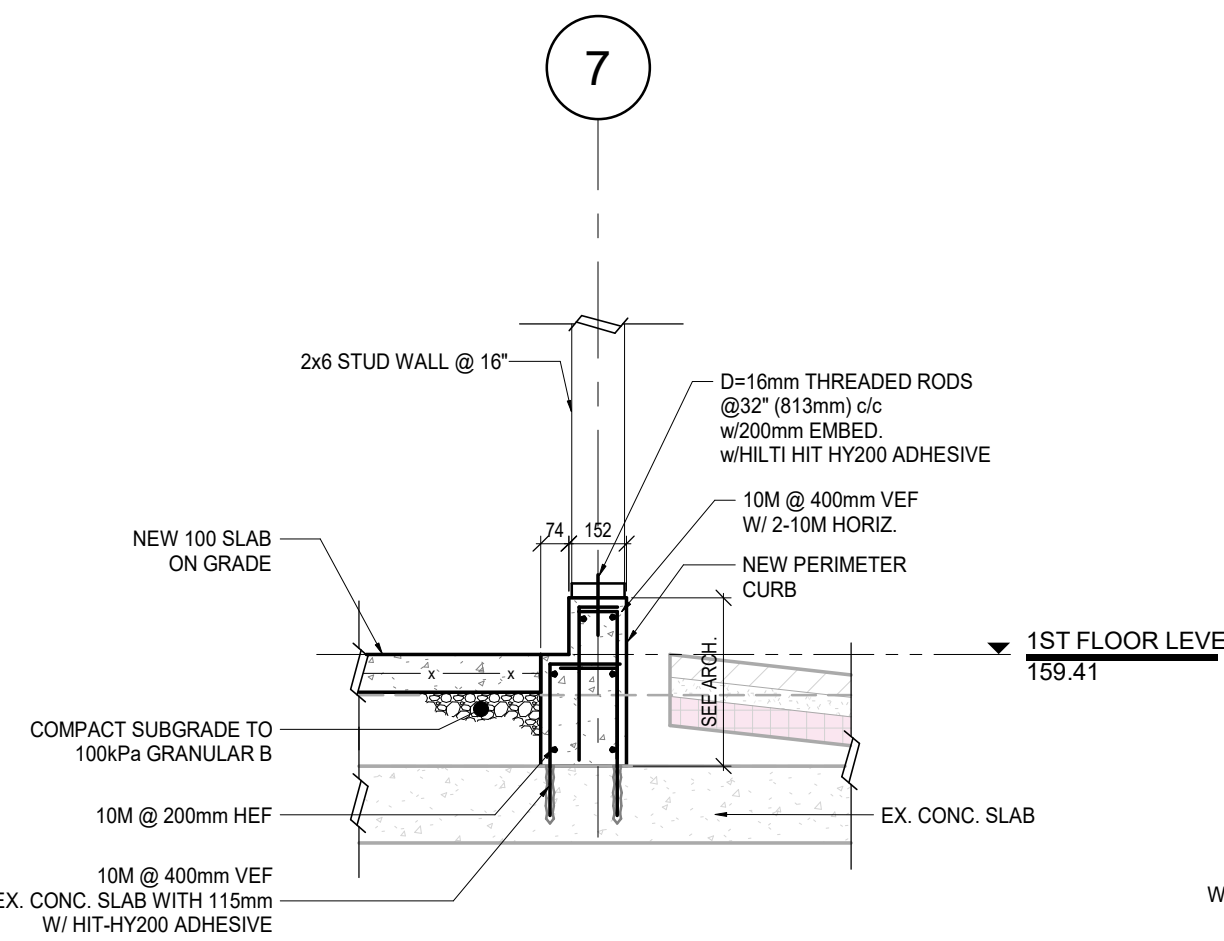


3 SECTION
S401 1 : 20

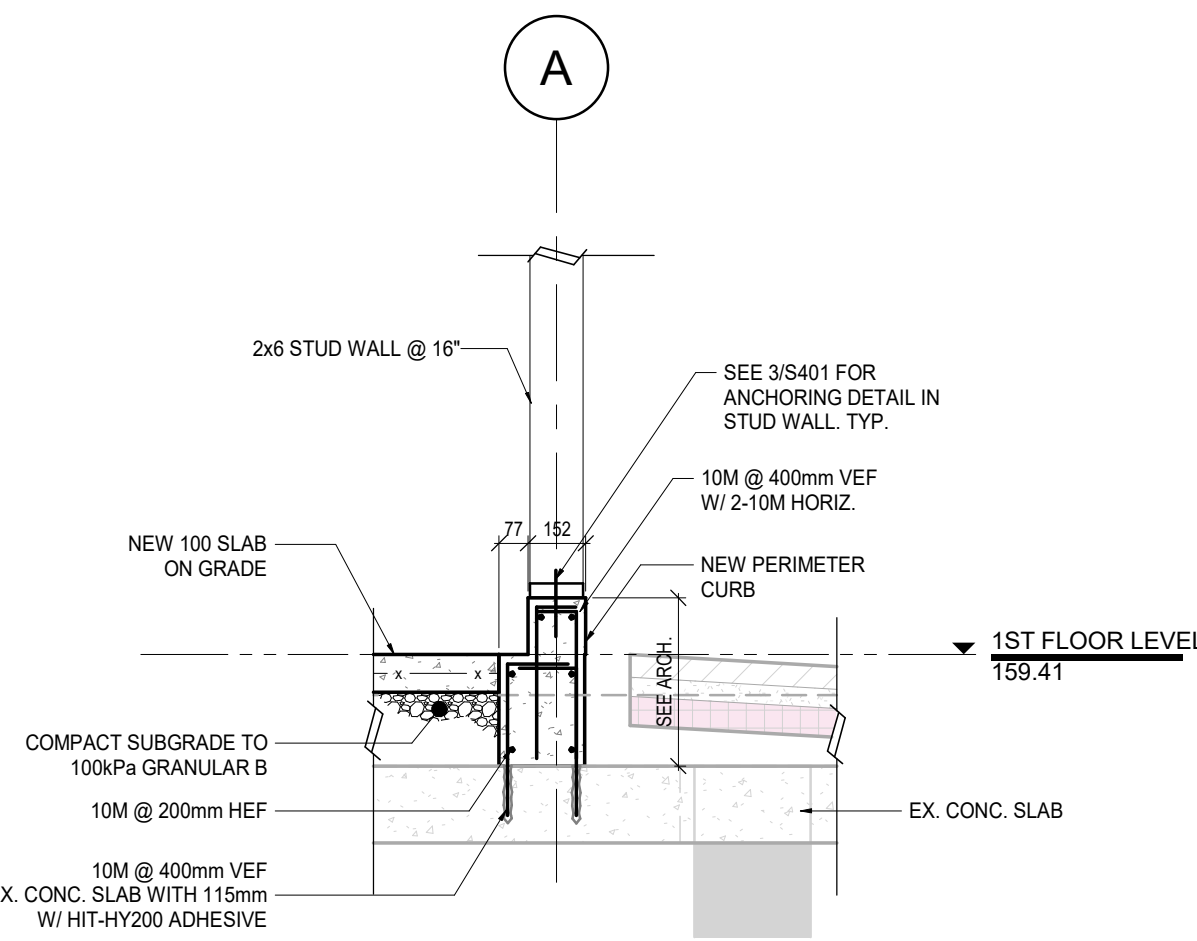


4 SECTION
S401 1 : 20

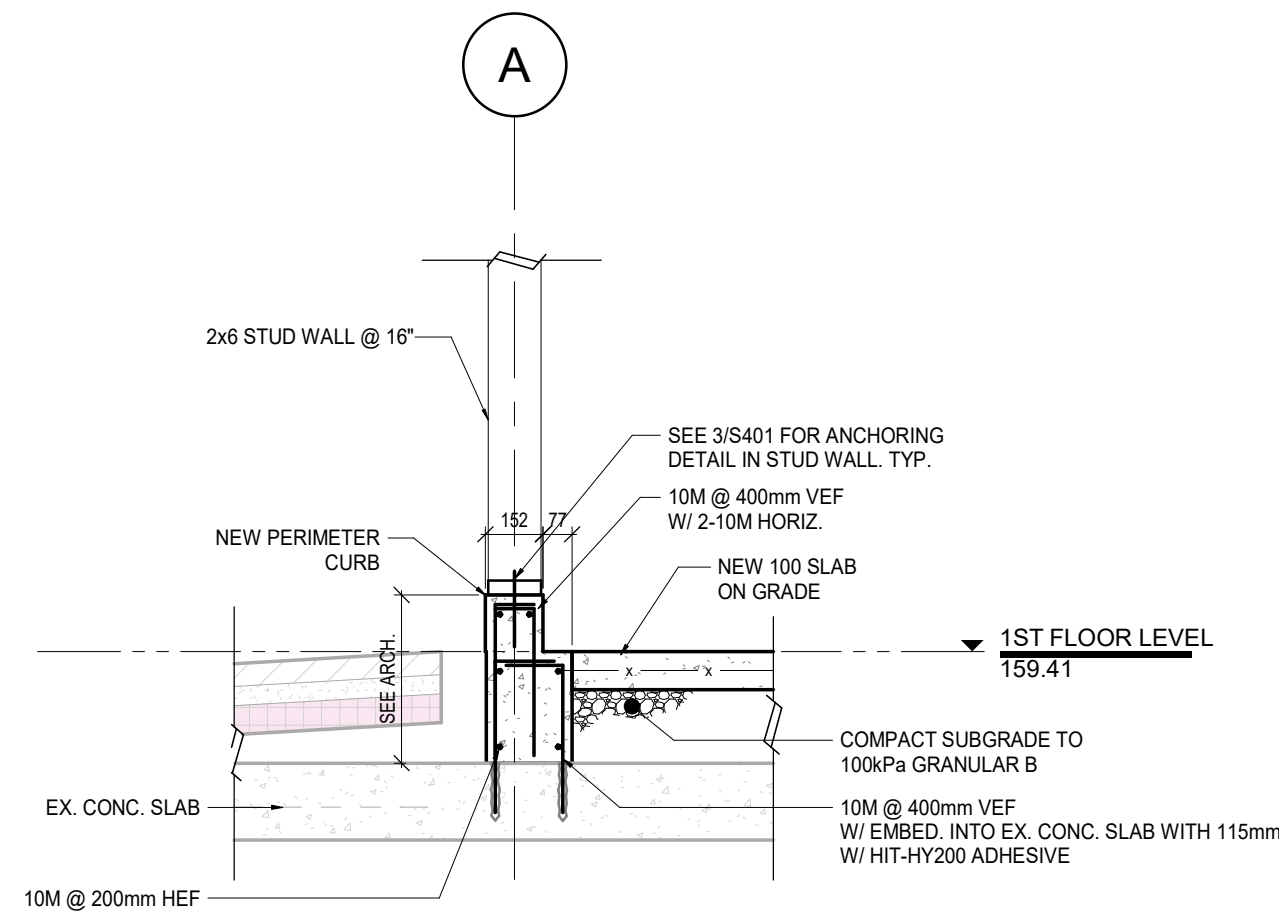


5 SECTION
S401 1 : 20

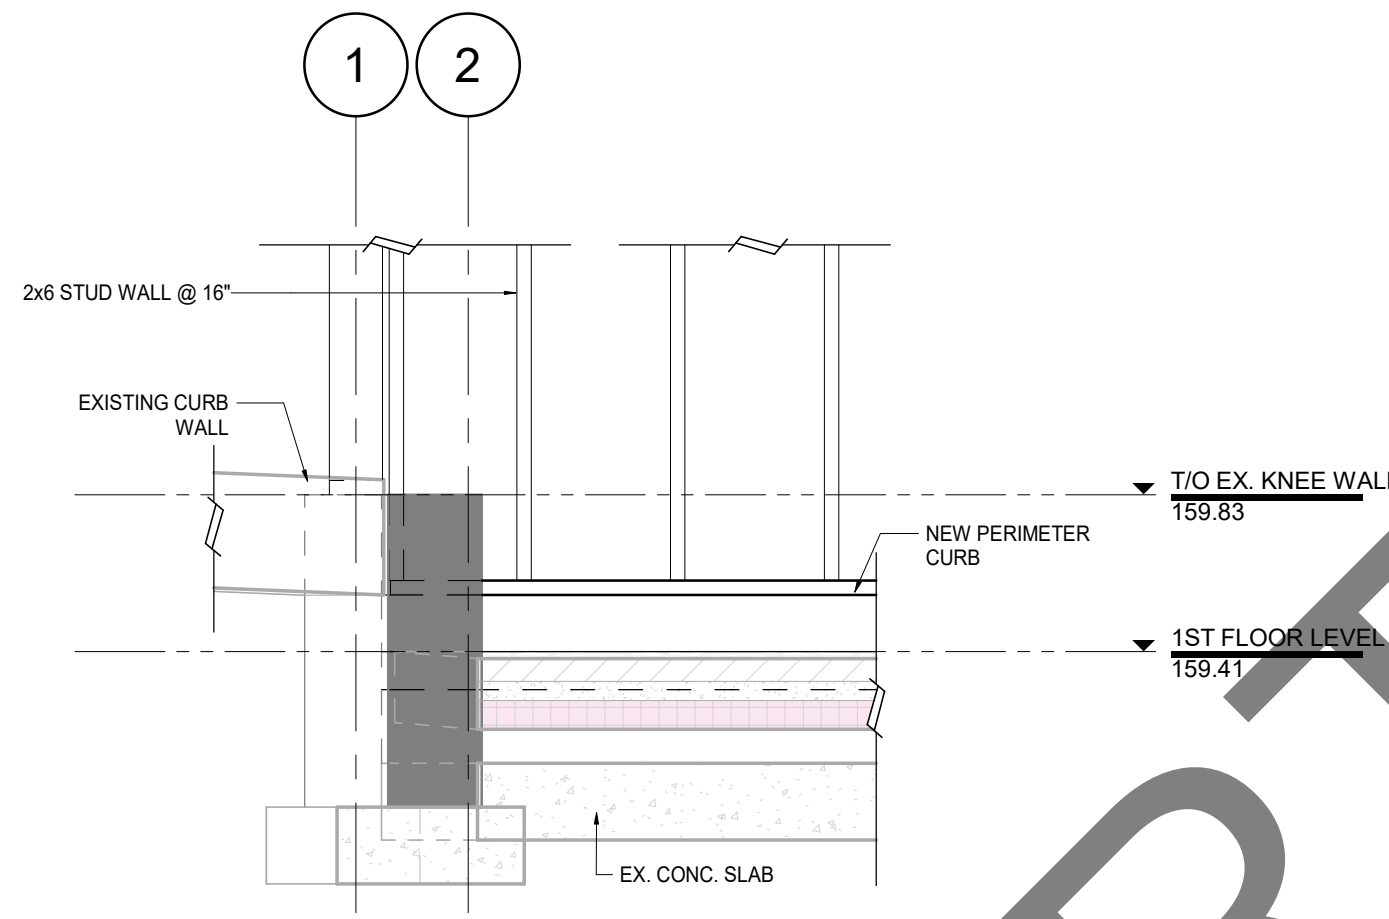


6 SECTION
S401 1 : 20

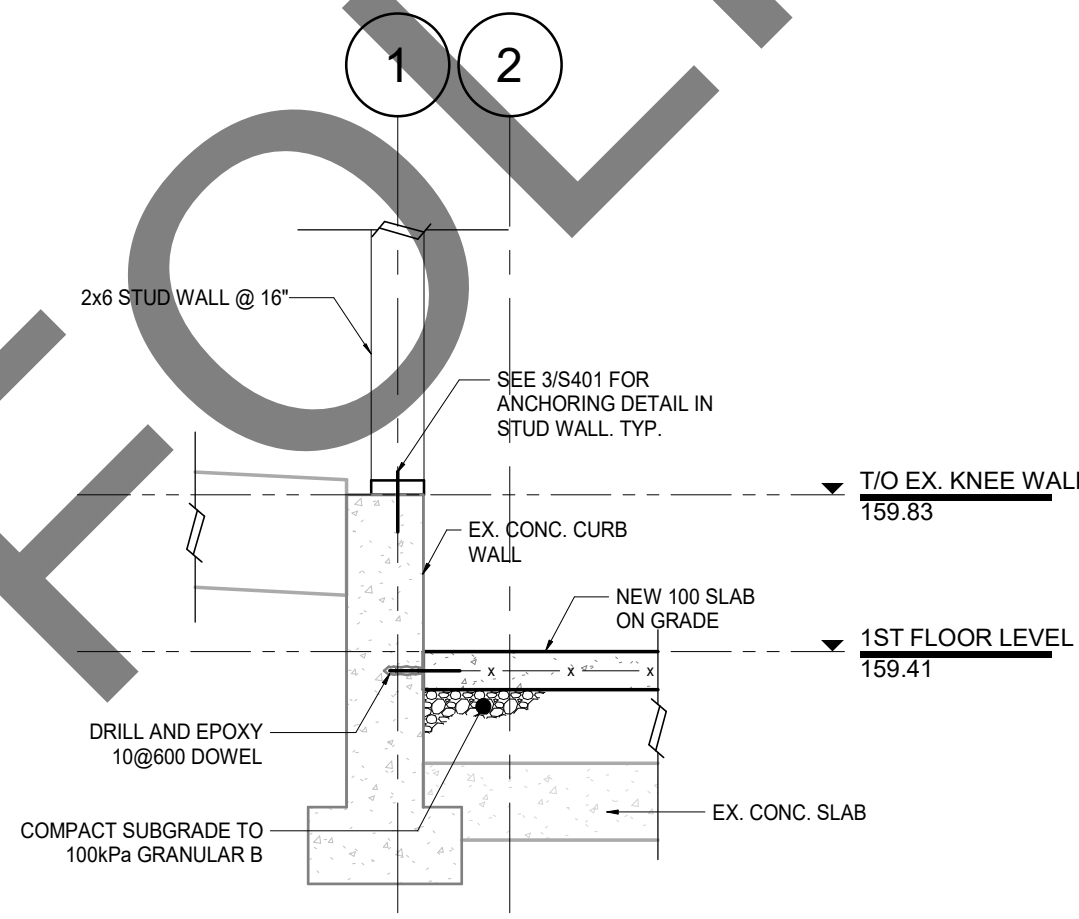


7 SECTION
S401 1 : 20

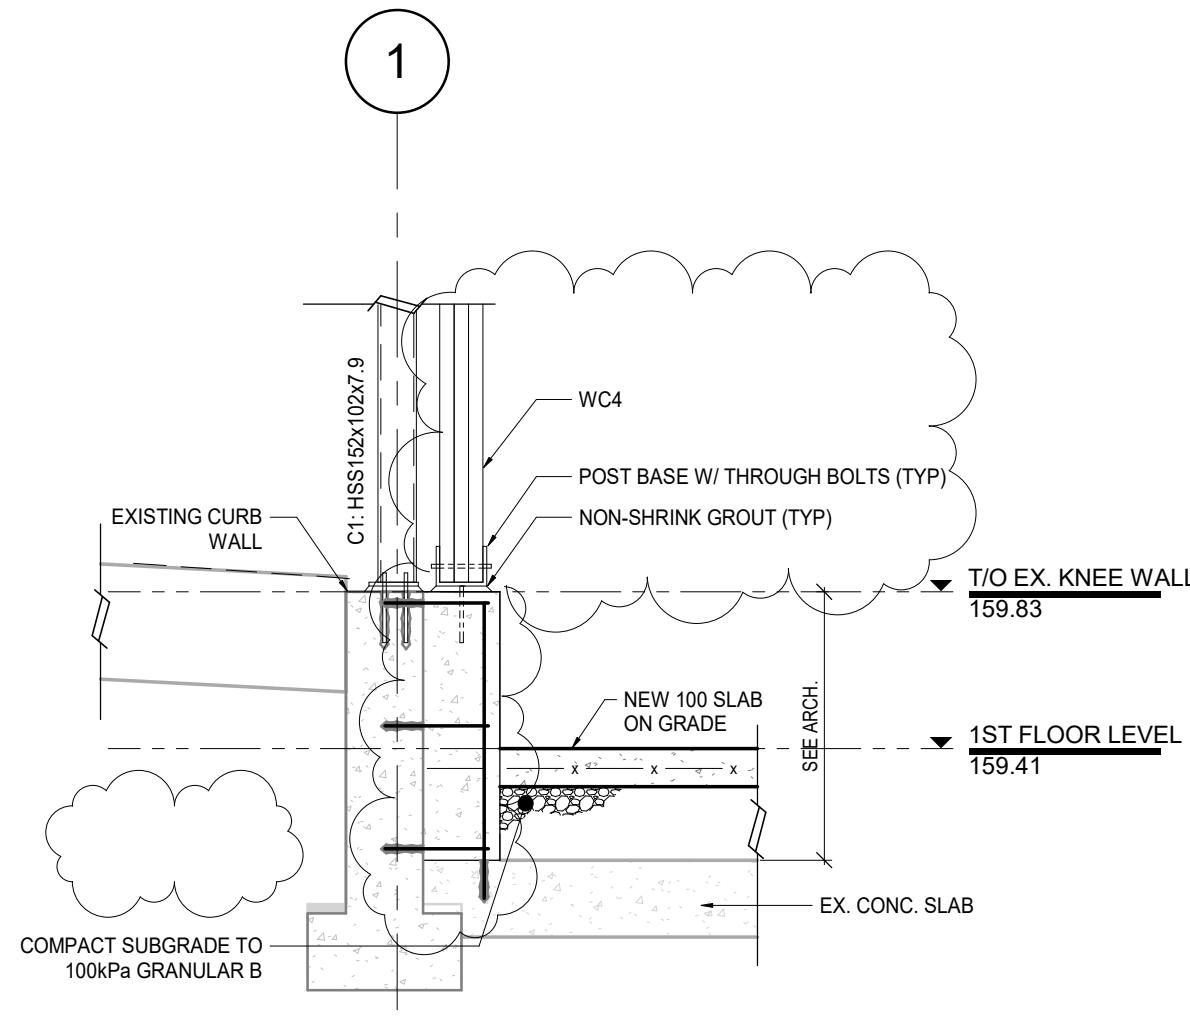


8 SECTION
S401 1 : 20

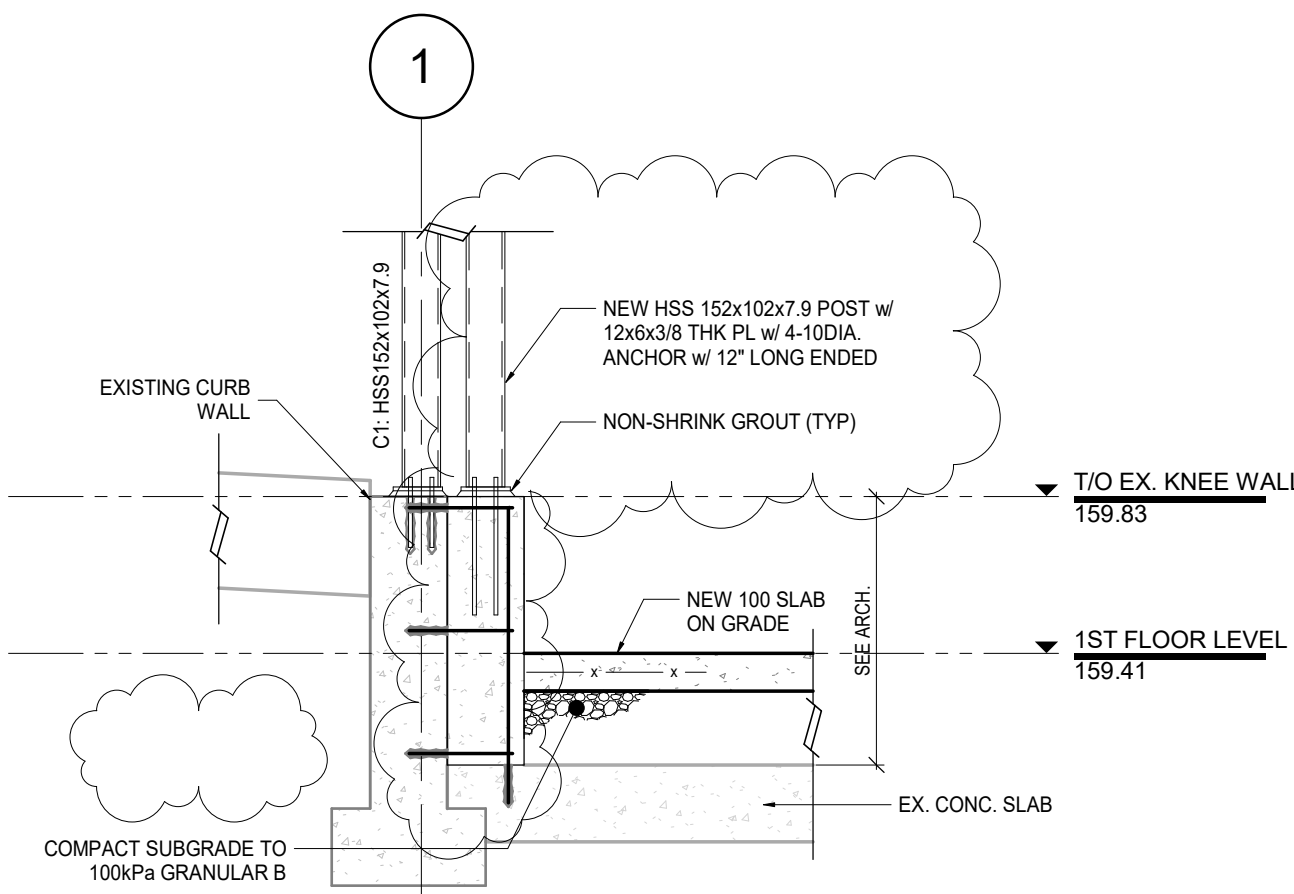

9 SECTION
S401 1 : 20

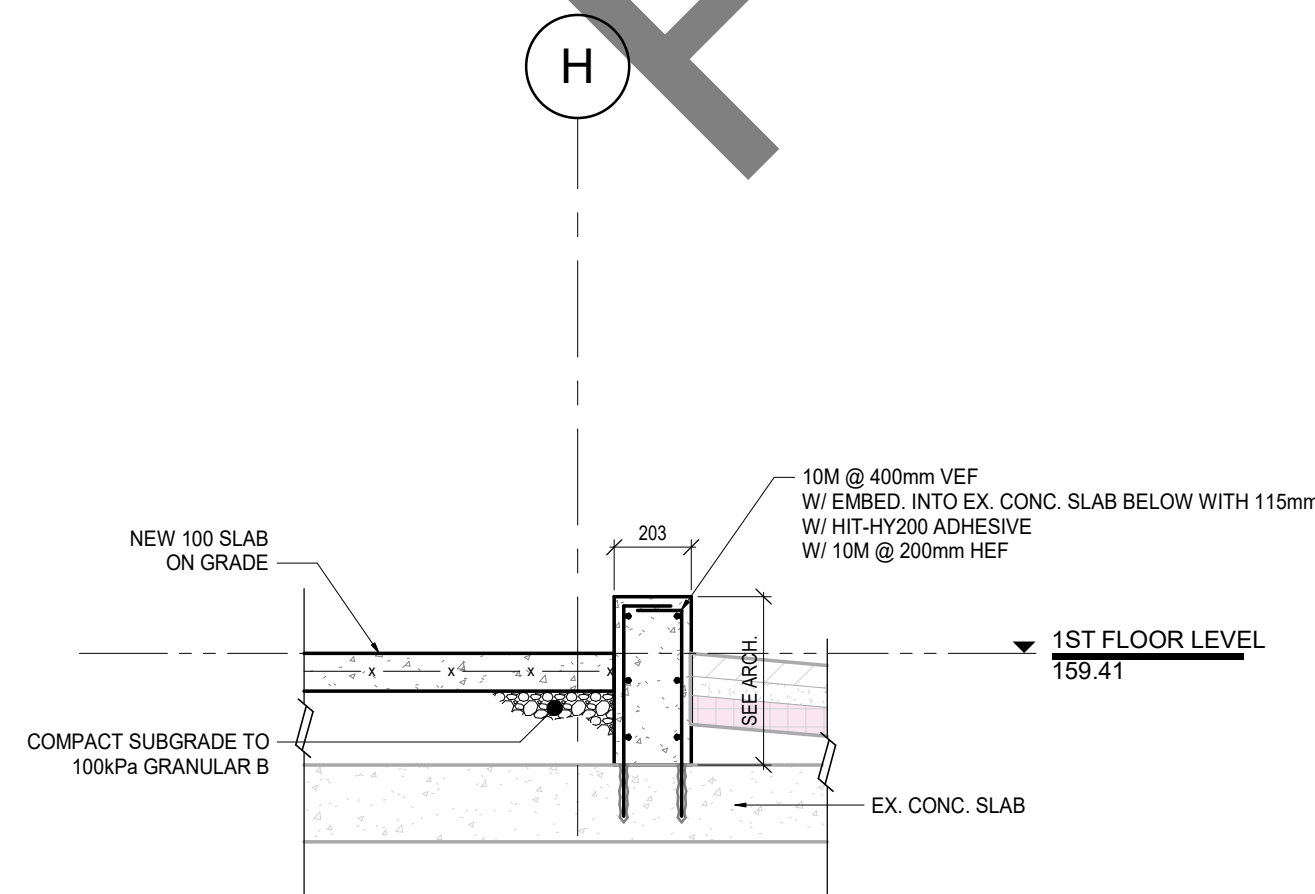

10 SECTION
S401 1 : 20

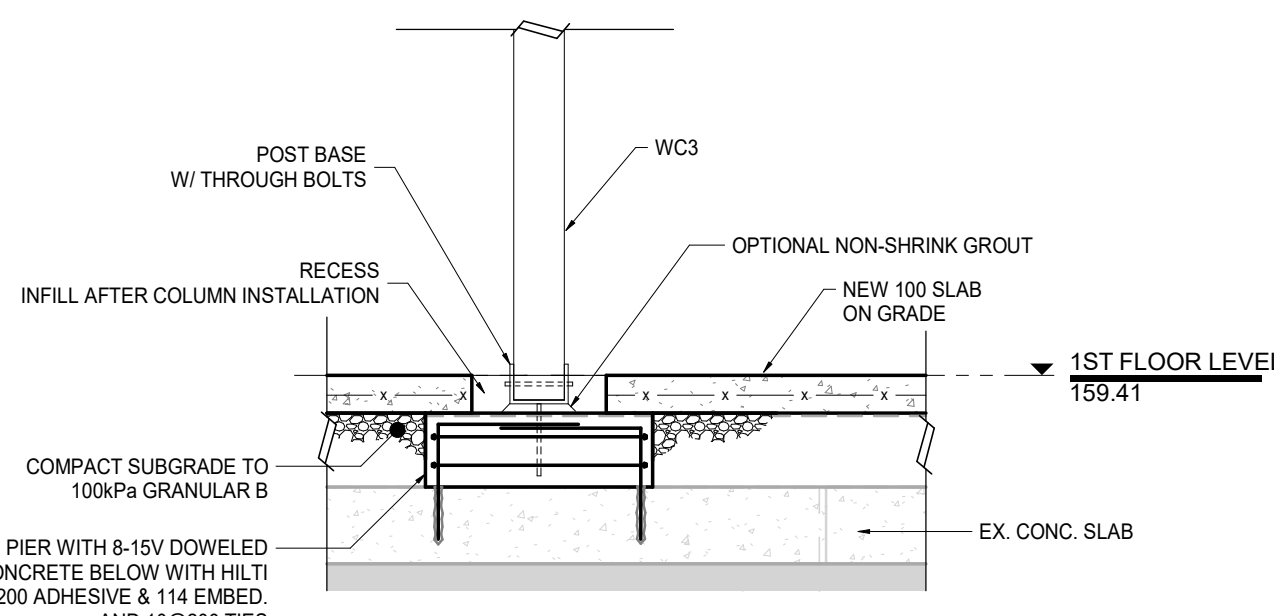

11 SECTION
S401 1 : 20


NOTES:
X-RAY OR REBAR SCAN EXISTING CONCRETE SLABS, BEAMS AND COLUMNS TO LOCATE EXISTING REINFORCING STEEL, STIRRUPS, TIES, AND CONDUITS. DO NOT DRILL THROUGH ANY EXISTING REINFORCEMENT AND DO NOT CUT ANY EXISTING CONDUITS.

ALL EXISTING INFORMATION SHOWN ON DRAWINGS IS TRANSFERRED FROM EXISTING BASE BUILDING DRAWINGS. CONTRACTOR SHALL BE RESPONSIBLE TO SITE VERIFY THE ACCURACY OF THESE DOCUMENTS WITH AS-BUILT CONDITIONS. ALL DETERMINATION OF EXISTING CONDITIONS MUST BE MADE PRIOR TO ANY STRUCTURAL DEMOLITION.

1 2024-09-25 ISSUED FOR PERMIT
2 2024-10-28 ISSUED FOR CONSTRUCTION
3 2025-01-23 ISSUED FOR COORDINATION



RAIMONDO
+ ASSOCIATES
ARCHITECTS INC.

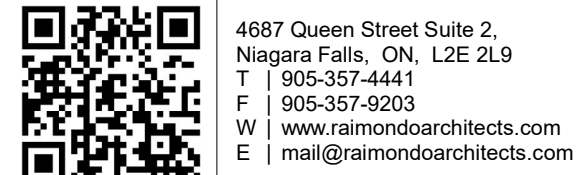

CLIENT NAME

Niagara Adventure Excursion Inc.

PROJECT NAME

Grand View Marketplace
Starbucks

PROJECT ADDRESS

5920 Niagara River Pkwy, Niagara Falls, ON

SHEET NAME

SECTIONS

DRAWN BY: JC
DATE: 2025-01-23 10:50:44 AM
SCALE: 1 : 20
PROJECT NO.: 24-094
CHECKED: RY

DRAWINGS ARE NOT VALID FOR CONSTRUCTION UNTIL SEALED AND SIGNED BY THE ARCHITECT.
DO NOT SCALE DRAWINGS. REPORT ALL DISCREPANCIES TO THE ARCHITECT BEFORE PROCEEDING. ALL DRAWINGS AND DESIGNS REMAIN THE PROPERTY OF THE ARCHITECT, AND ARE PROTECTED UNDER COPYRIGHT.


THESE DESIGN DOCUMENTS ARE PREPARED SOLELY FOR THE USE BY THE PARTY WITH WHOM THE DESIGN PROFESSIONAL HAS ENTERED INTO A CONTRACT AND THERE ARE NO REPRESENTATIONS OF ANY KIND MADE BY THE DESIGN PROFESSIONAL TO ANY PARTY WITH WHOM THE DESIGN PROFESSIONAL HAS NOT ENTERED INTO A CONTRACT.

SHEET #

S401

REV. #

G:\Shared drives\Project Drafting\24-494\2D QDA Drafting\24-494.GV Starbucks\Working File\24-494 - NAE - G.V Marketplace (Starbucks) R25_Structure.rvt

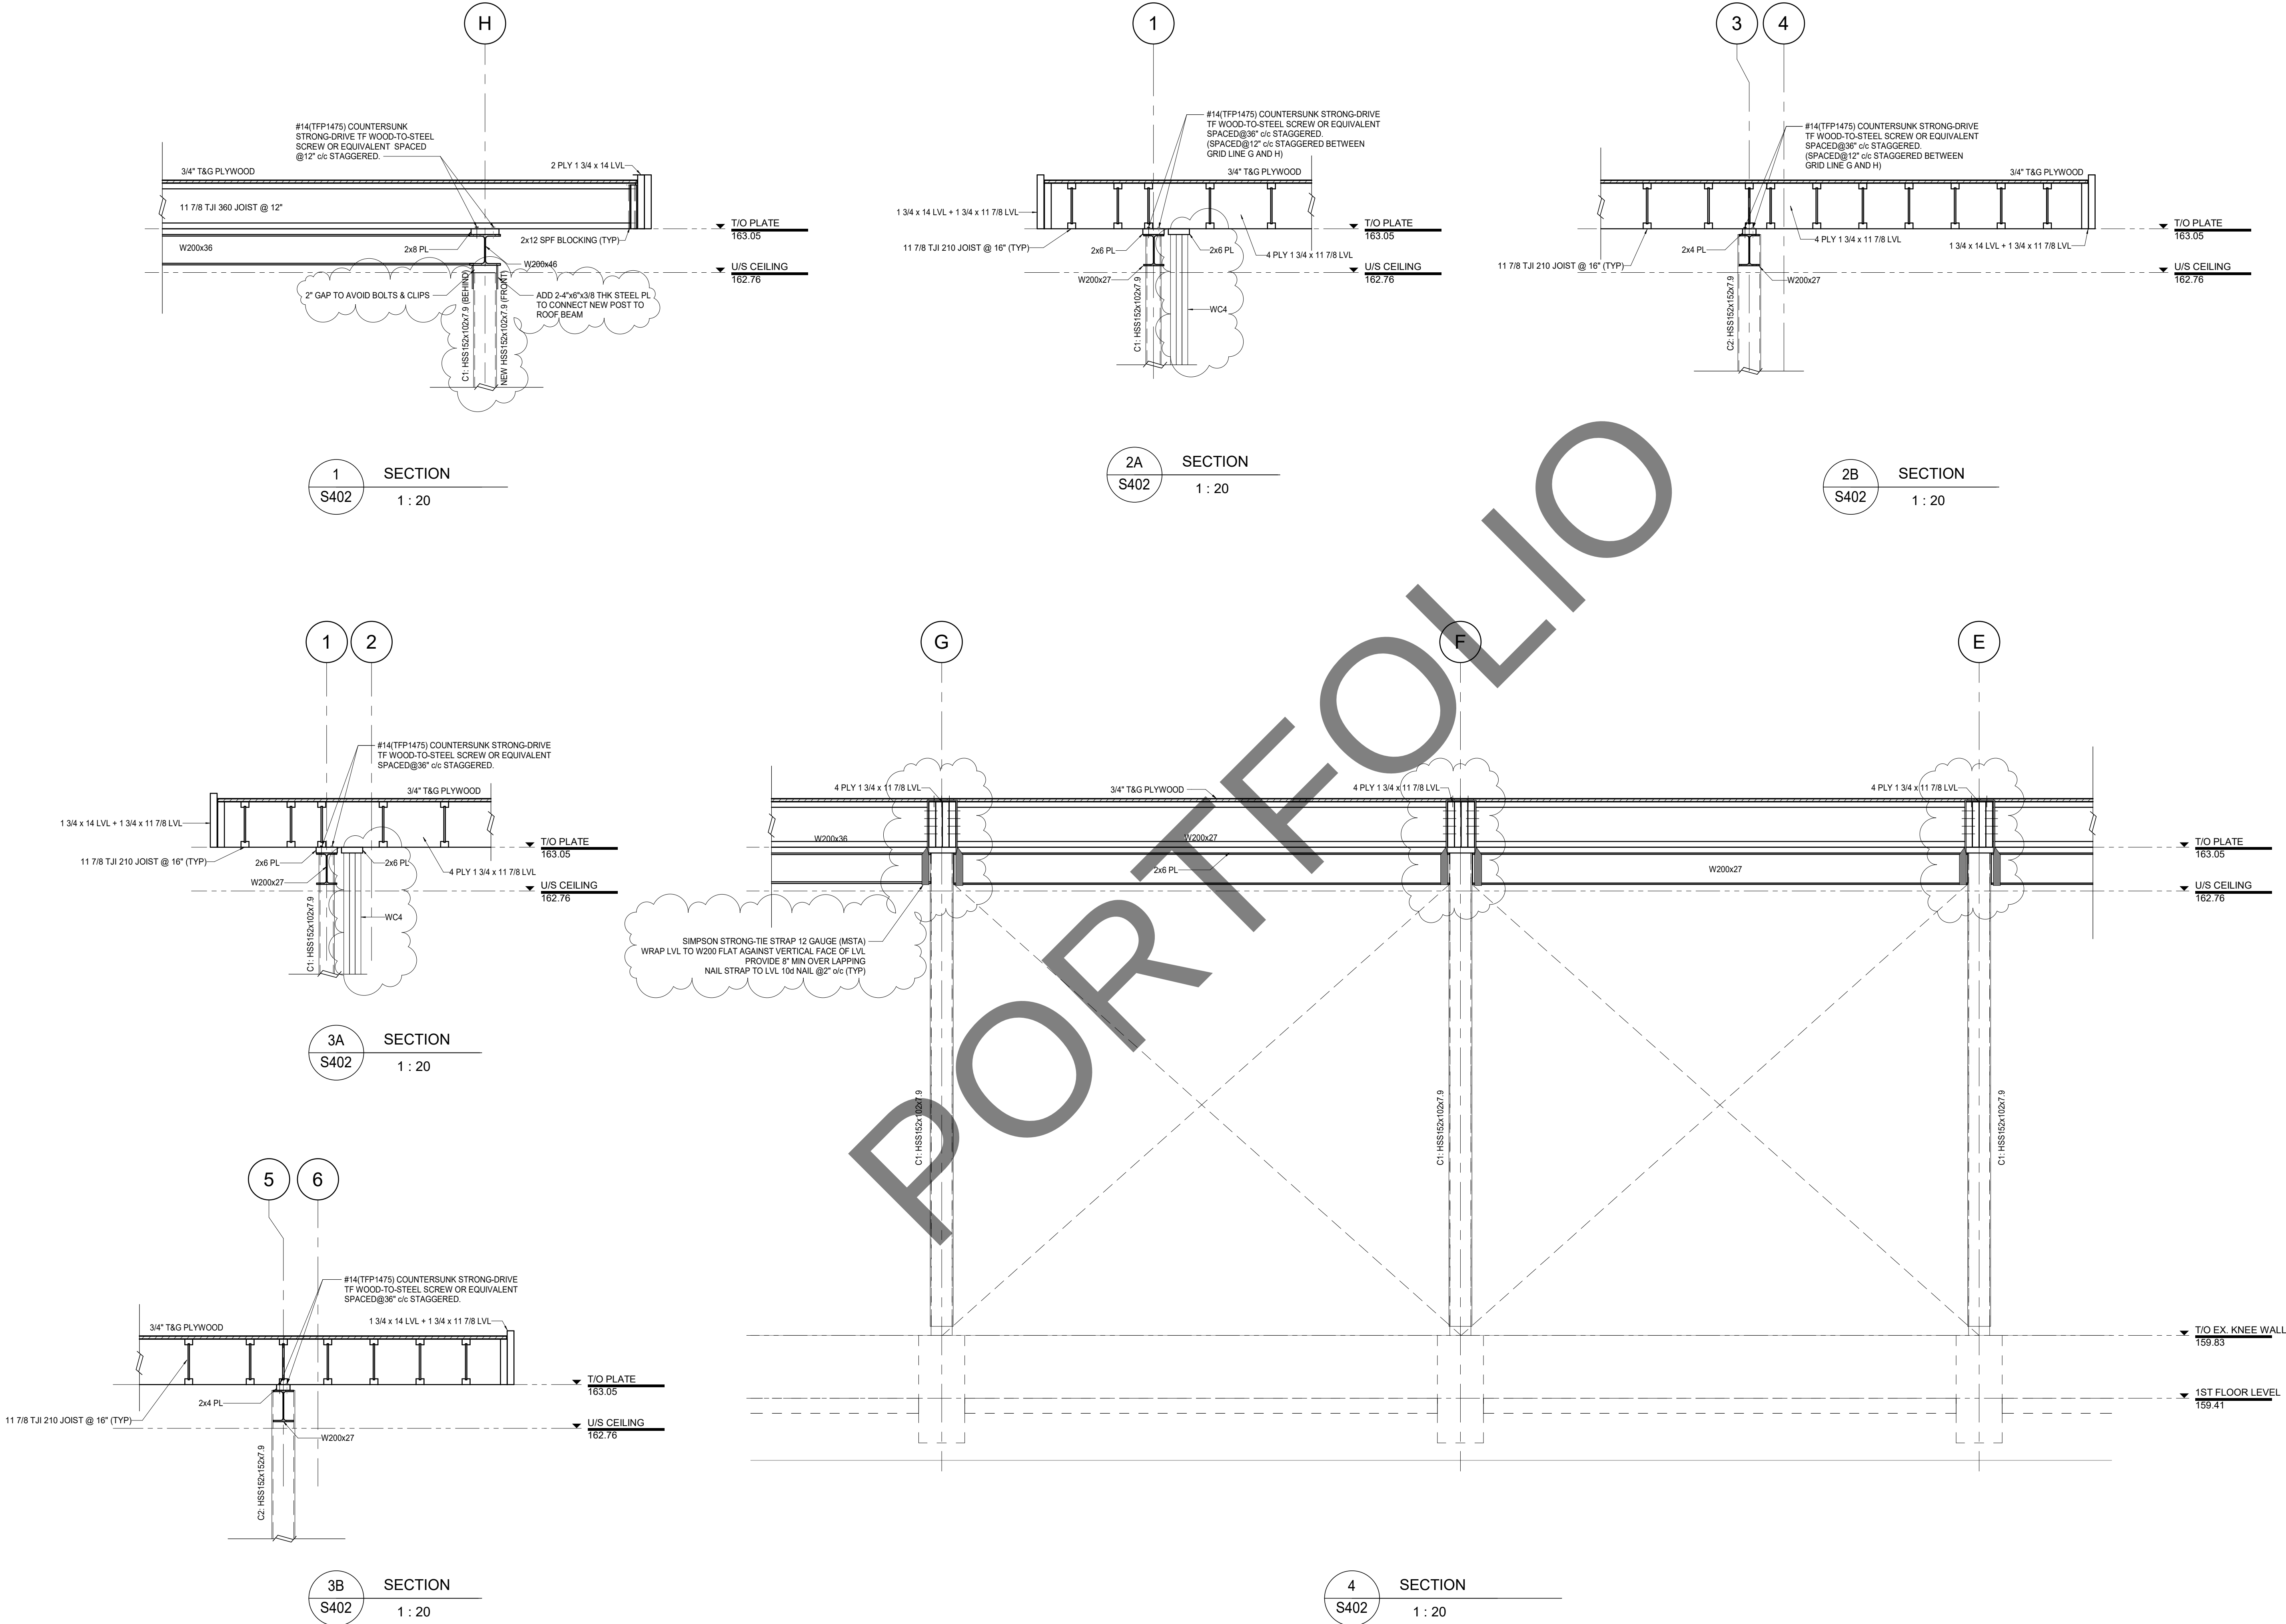

1 2024-09-25 ISSUED FOR PERMIT
2 2024-10-28 ISSUED FOR CONSTRUCTION
3 2025-01-23 ISSUED FOR COORDINATION



Quinn Dressel
ASSOCIATES
CONSULTING STRUCTURAL ENGINEERS

RAIMONDO
+ ASSOCIATES
ARCHITECTS INC.



4687 Queen Street Suite 2,
Niagara Falls, ON, L2E 2L9
T | 905-357-4441
F | 905-357-9203
W | www.raimondoaarchitects.com
E | mail@raimondoaarchitects.com

CLIENT NAME

Niagara Adventure Excursion Inc.

PROJECT NAME

Grand View Marketplace
Starbucks

PROJECT ADDRESS

5920 Niagara River Pkwy, Niagara Falls, ON

SHEET NAME

SECTIONS

DRAWN BY: JC
DATE: 2025-01-23 10:50:46 AM
SCALE: 1 : 20
PROJECT NO.: 24-094
CHECKED: RY

DRAWINGS ARE NOT VALID FOR CONSTRUCTION UNTIL SEALED AND
SIGNED BY THE ARCHITECT.

DO NOT SCALE DRAWINGS. REPORT ALL DISCREPANCIES TO THE
ARCHITECT BEFORE PROCEEDING. ALL DRAWINGS AND DESIGNS
REMAIN THE PROPERTY OF THE ARCHITECT, AND ARE PROTECTED
UNDER COPYRIGHT.






THESE DESIGN DOCUMENTS ARE PREPARED SOLELY FOR THE USE
BY THE PARTY WITH WHOM THE DESIGN PROFESSIONAL HAS
ENTERED INTO A CONTRACT AND THERE ARE NO REPRESENTATIONS
OF ANY KIND MADE BY THE DESIGN PROFESSIONAL TO ANY PARTY
WITH WHOM THE DESIGN PROFESSIONAL HAS NOT ENTERED INTO A
CONTRACT.

SHEET #

S402

REV. #

G:\Shared drives\Project Drafting\24-494\QDA Drafting 24-494 GV Starbucks\Working File\24-494 - G.V. Marketplace (Starbucks) R25_Structure.rvt

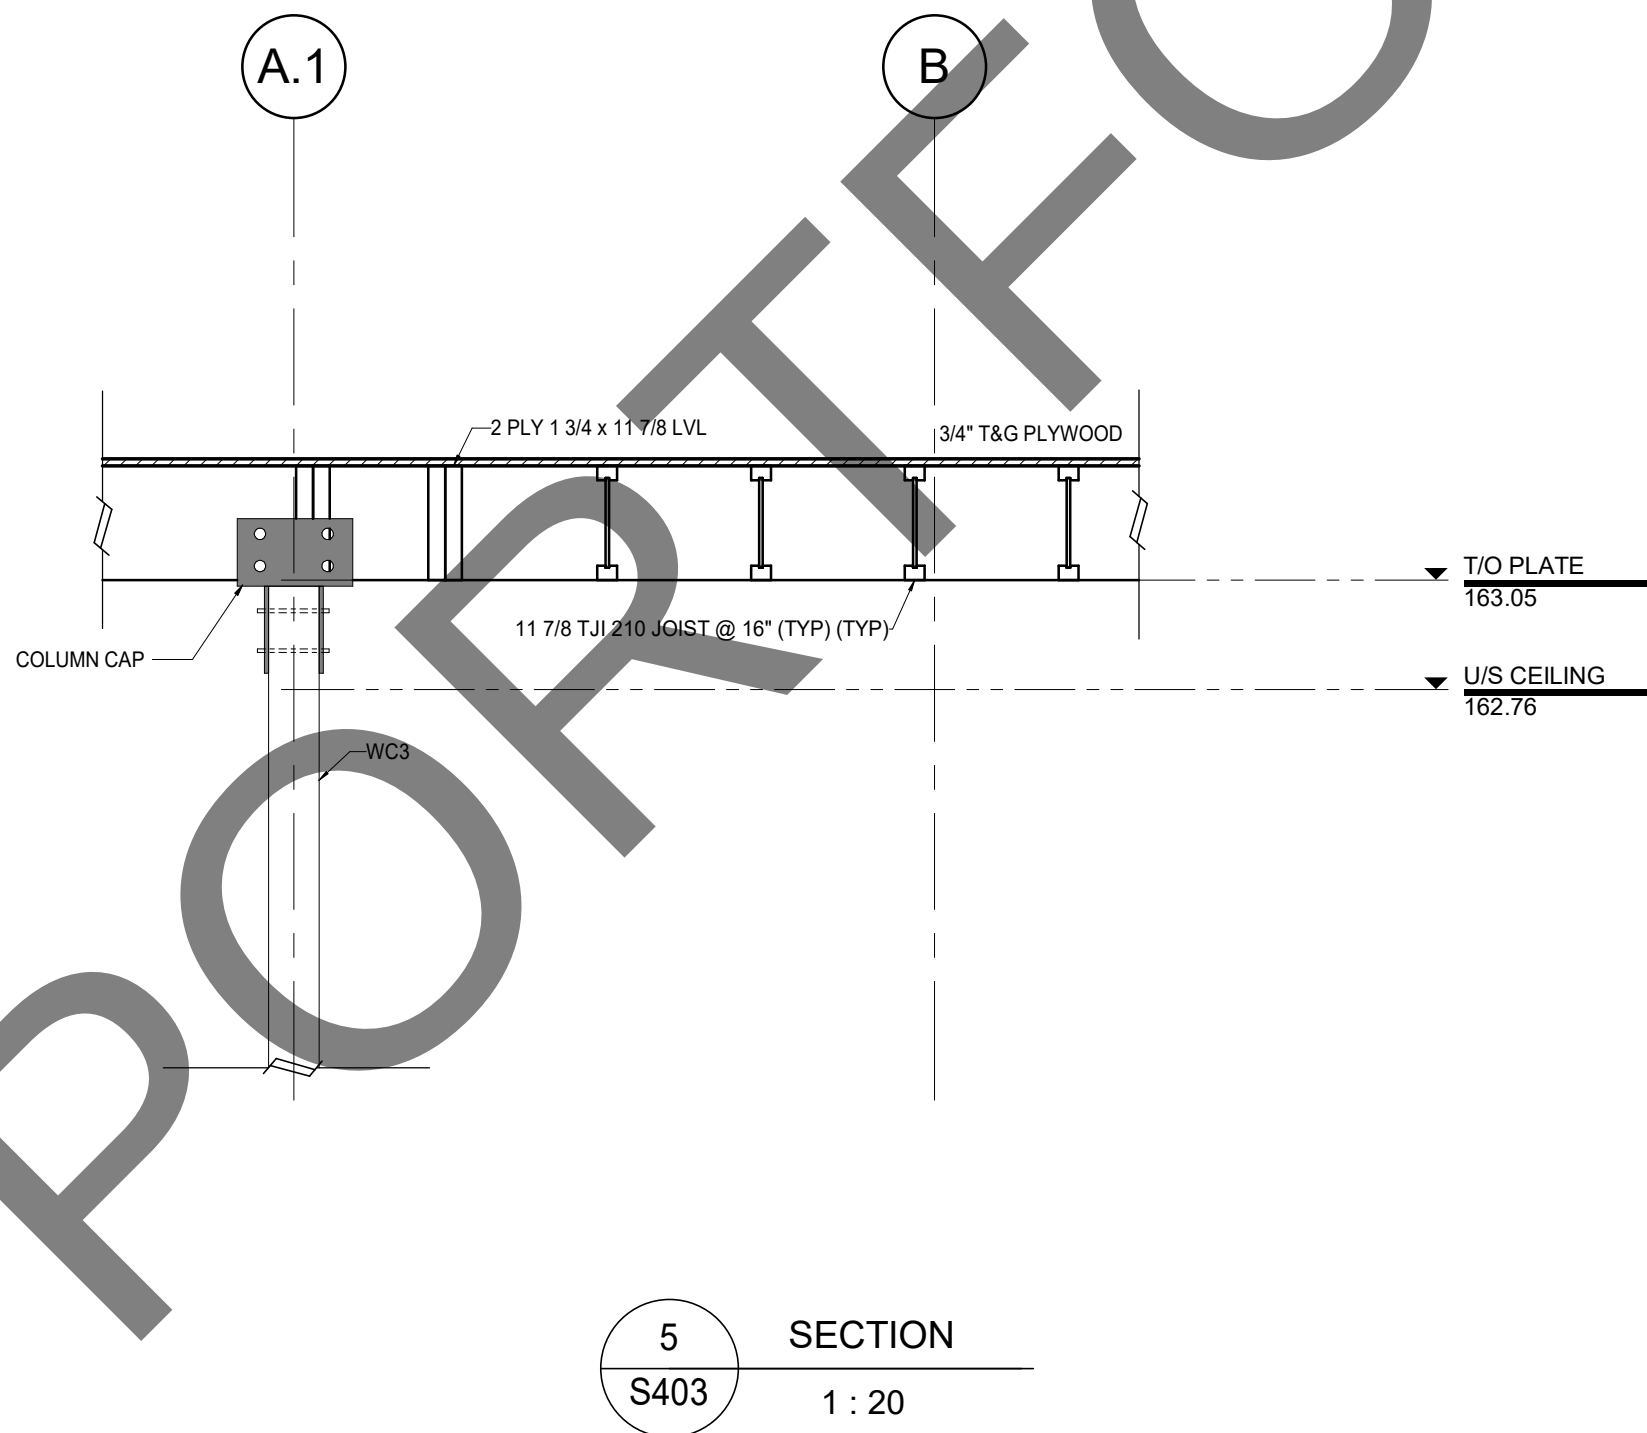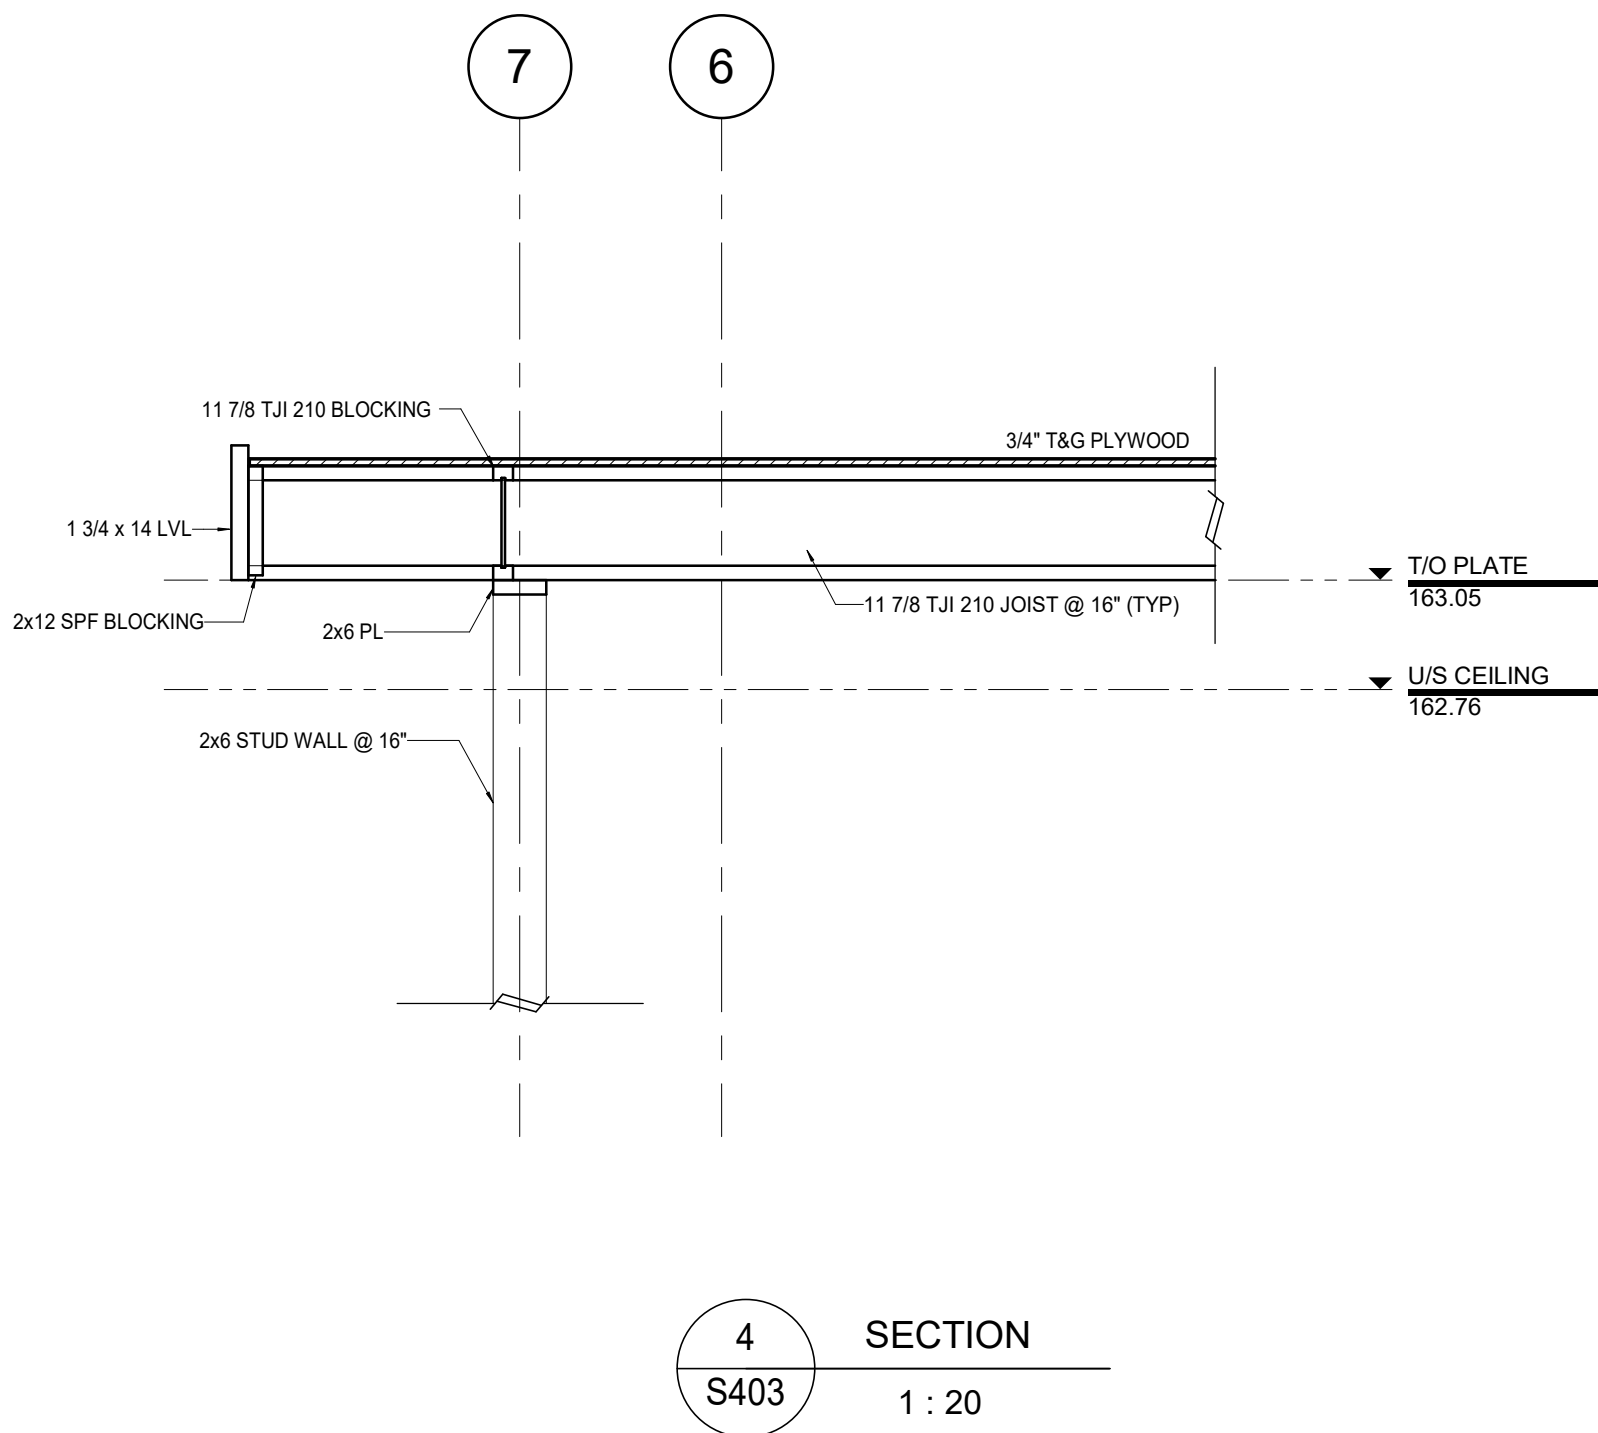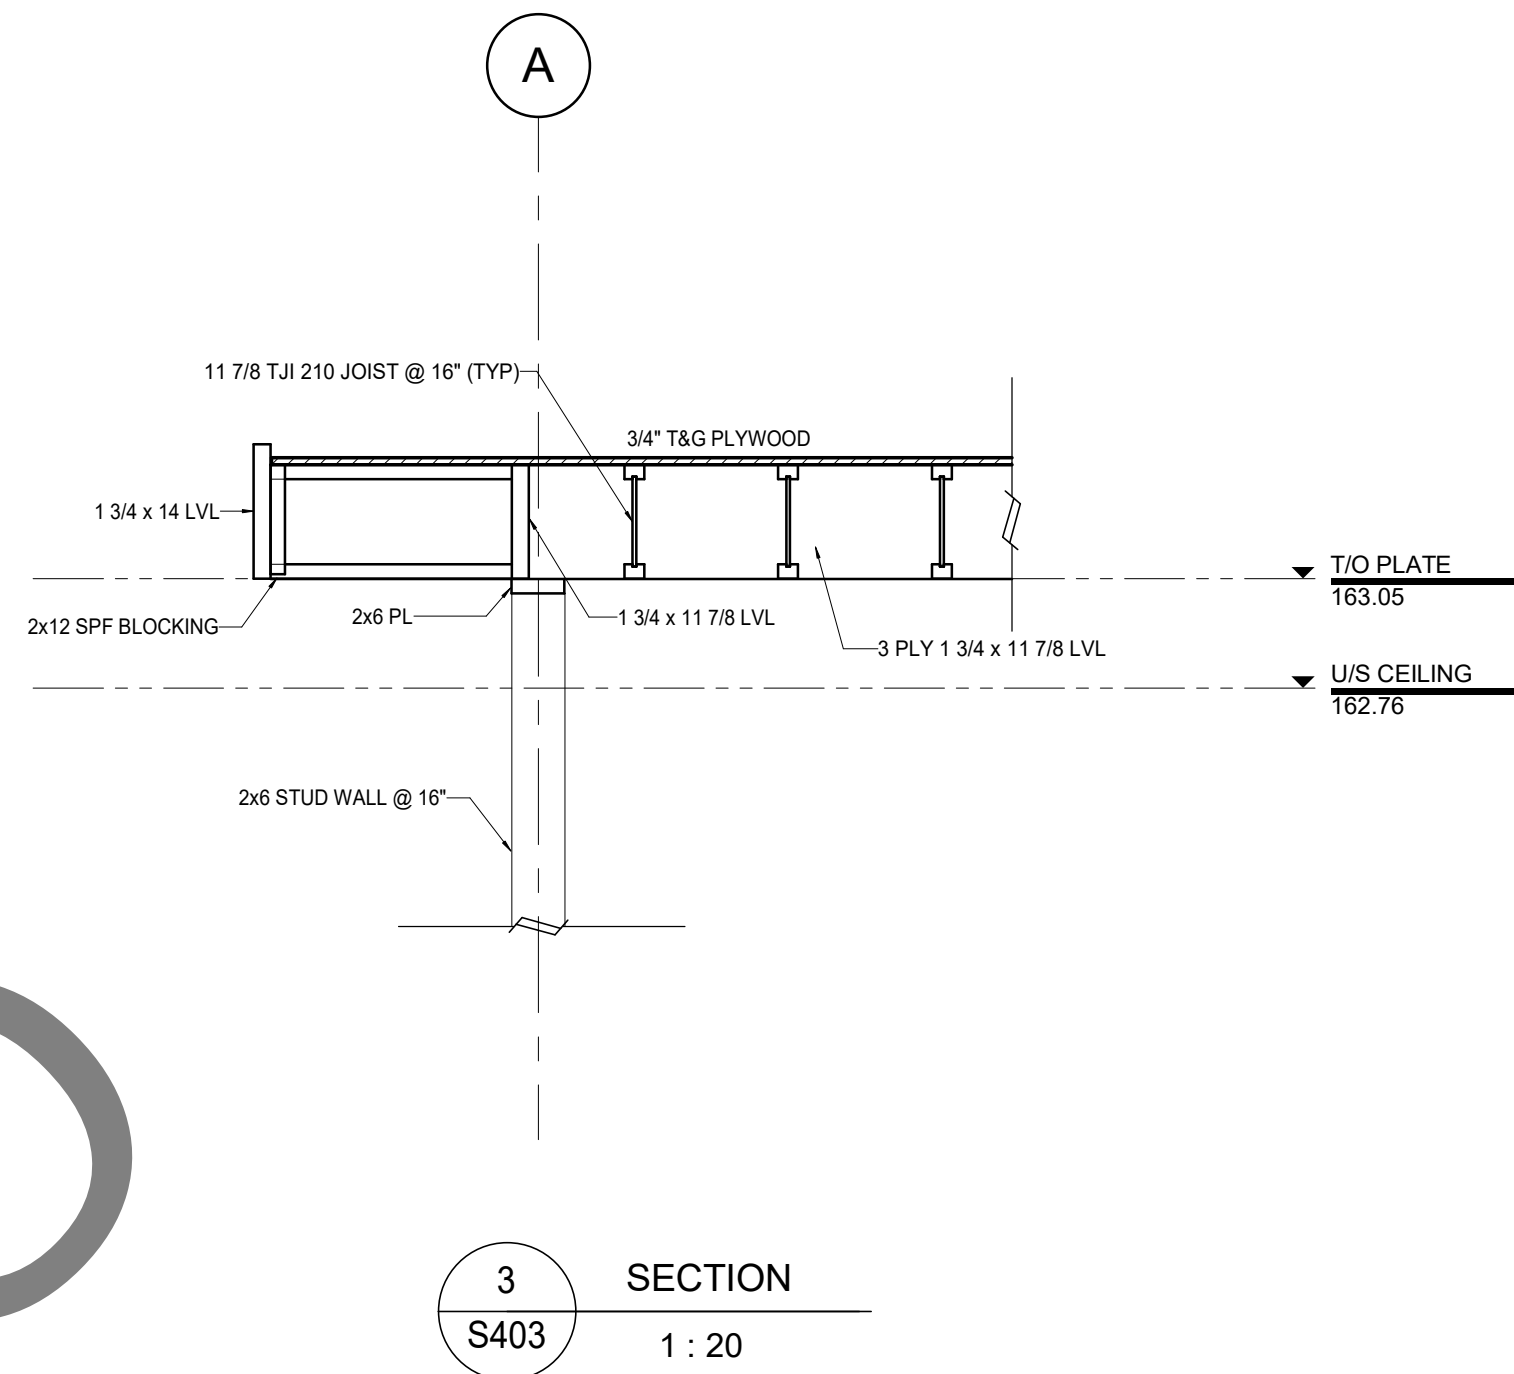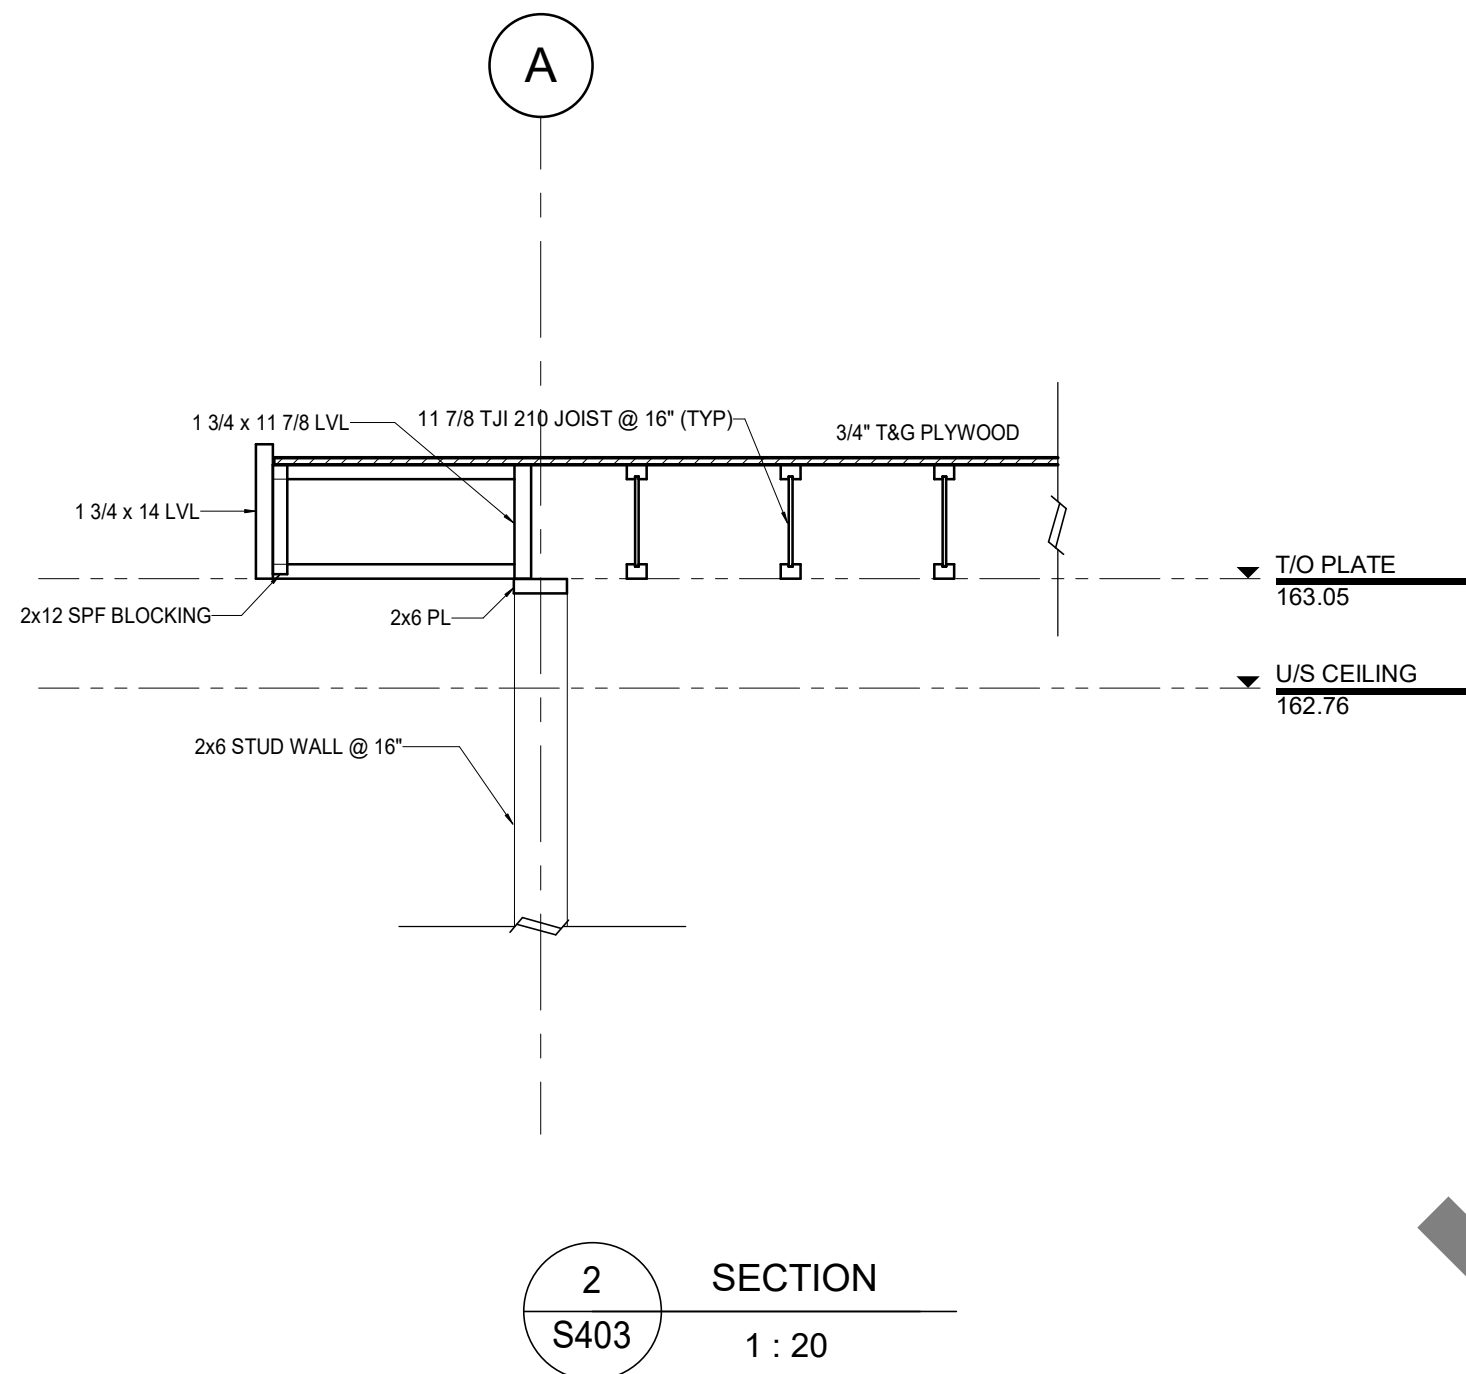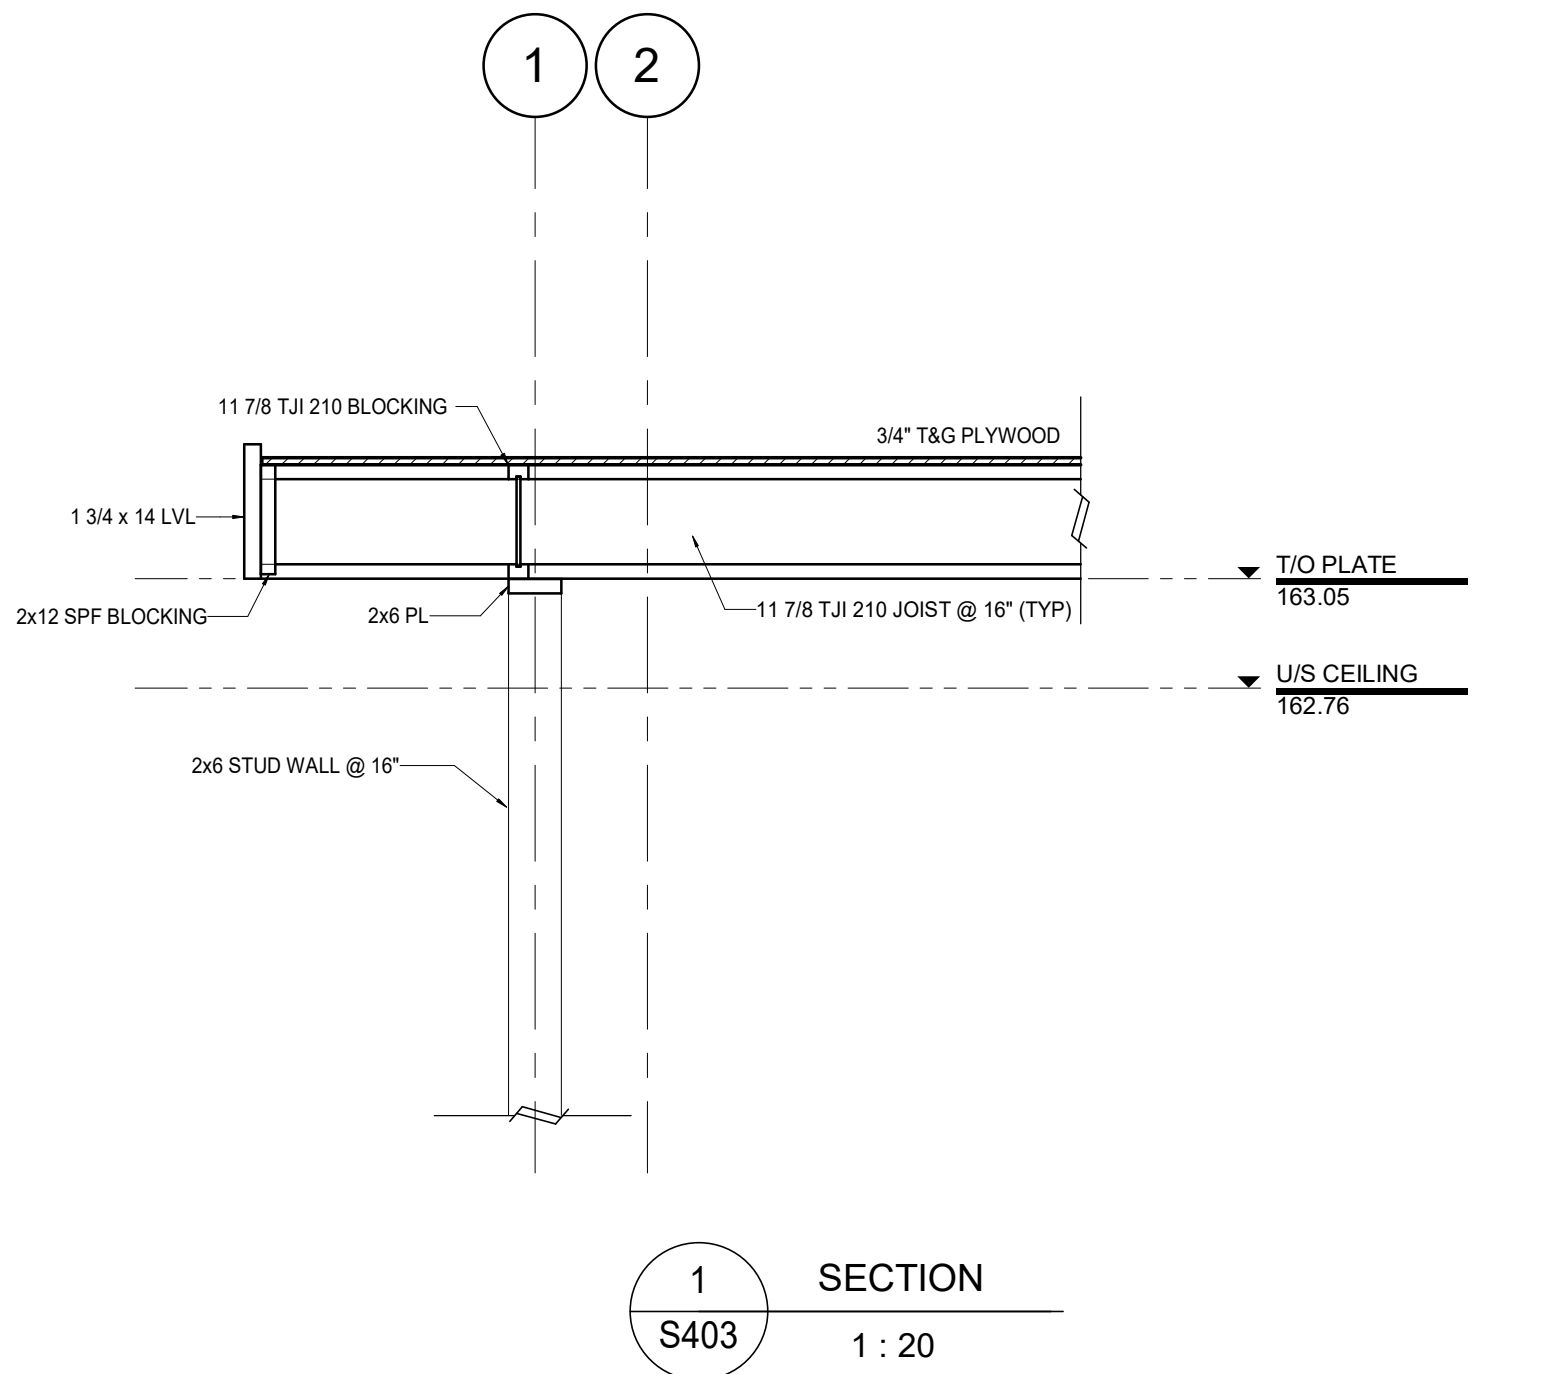

1 2024-09-25 ISSUED FOR PERMIT
2 2024-10-28 ISSUED FOR CONSTRUCTION



Quinn Dressel
ASSOCIATES
CONSULTING STRUCTURAL ENGINEERS

RAIMONDO
+ ASSOCIATES
ARCHITECTS INC.



4687 Queen Street Suite 2,
Niagara Falls, ON, L2E 2L9
T | 905-357-4441
F | 905-357-9203
W | www.raimondosarchitects.com
E | mail@raimondosarchitects.com

CLIENT NAME

Niagara Adventure Excursion Inc.

PROJECT NAME

Grand View Marketplace
Starbucks

PROJECT ADDRESS

5920 Niagara River Pkwy, Niagara Falls, ON

SHEET NAME

SECTIONS

DRAWN BY: JC

DATE: 2025-01-23 10:50:47 AM

SCALE: 1 : 20

PROJECT NO.: 24-094

CHECKED: RY

DRAWINGS ARE NOT VALID FOR CONSTRUCTION UNTIL SEALED AND
SIGNED BY THE ARCHITECT.

DO NOT SCALE DRAWINGS. REPORT ALL DISCREPANCIES TO THE
ARCHITECT BEFORE PROCEEDING. ALL DRAWINGS AND DESIGNS
REMAIN THE PROPERTY OF THE ARCHITECT, AND ARE PROTECTED
UNDER COPYRIGHT.

SHEET #

S403

REV. #